

CERTIFICATE OF SURVEY
for
Snyder Drilling Co.
Washington County, Colorado


RECEIVED

MAR 22 1974

COLORADO OIL & GAS CONS. COMM.



00066662

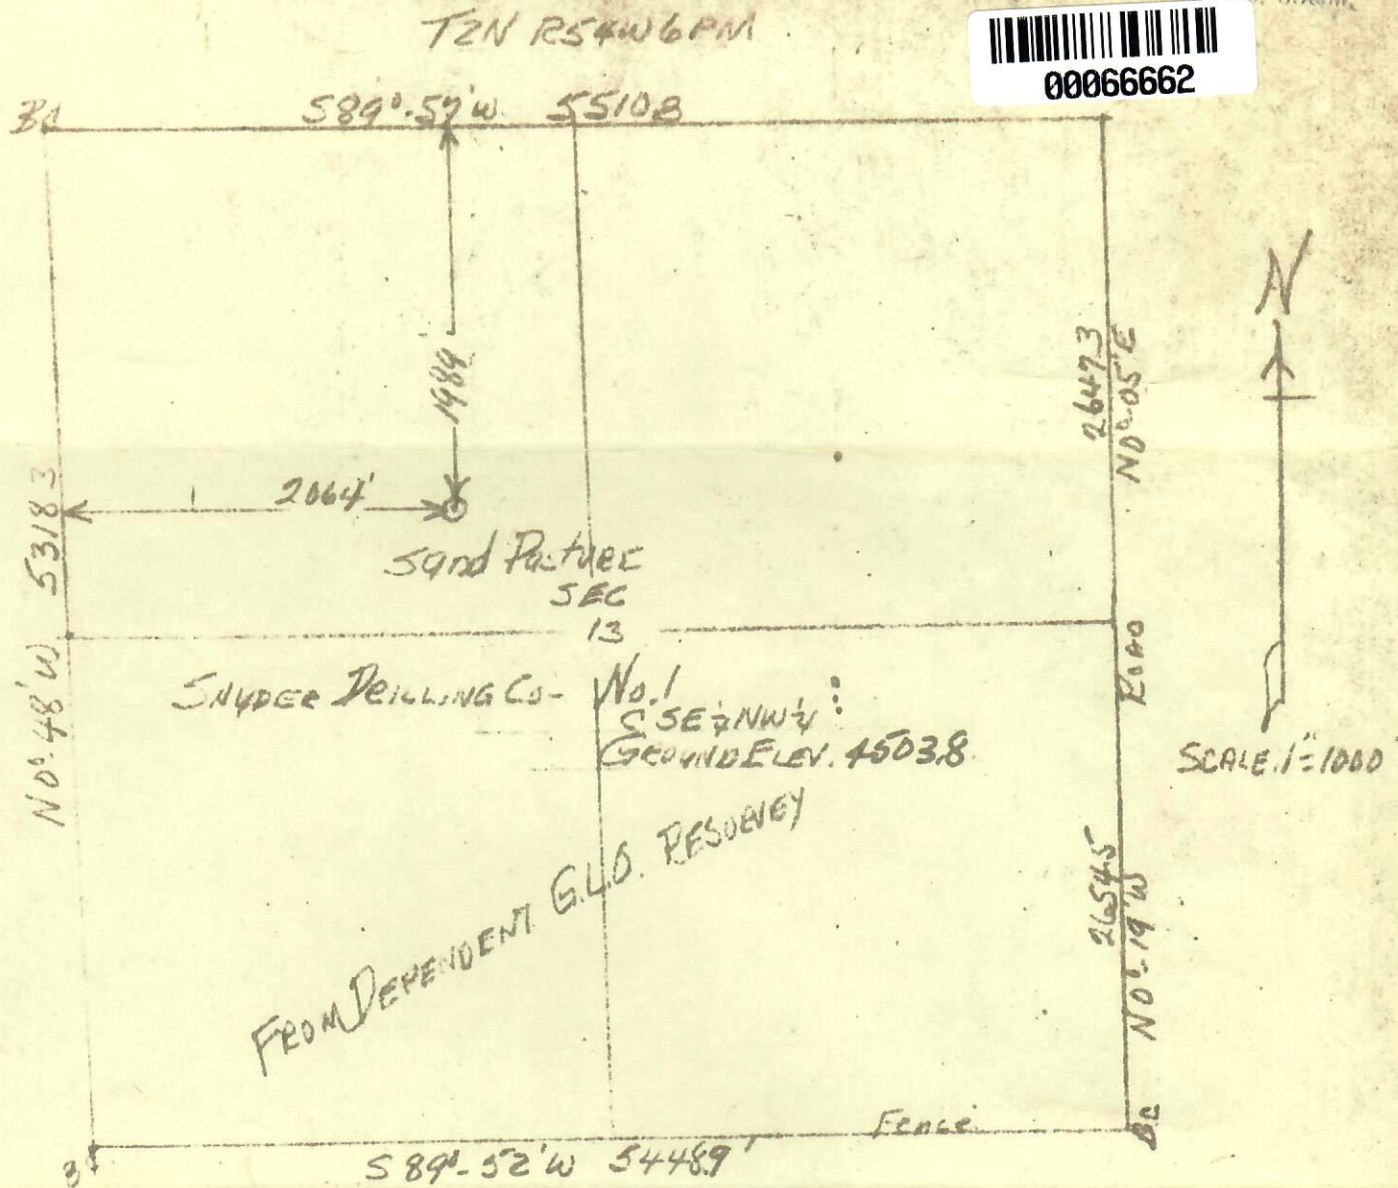

I hereby certify that the above plat is an accurate representation of a correct survey showing the location of Snyder Drilling Co.-No. 1 ALLEN Oilwell in S 32° NW 1/4 Sec. 13 T2N R54W 6PM. The elevation of the ground at the stake is 4503.8 feet above sea level from U.S.C.&G. Bench Mark.

Fort Morgan, Colorado
Feb. 17, 1974

Becky Osborne
Registered Professional Engineer
State of Colorado