

CERTIFICATE OF SURVEY
for
Patrick A. Doheny
Washington County, Colorado

Colo Oil & Gas Cons Com




RECEIVED

JAN 16 1967

COLO. OIL & GAS CONS. COMM.

T2N R54W 6PM.

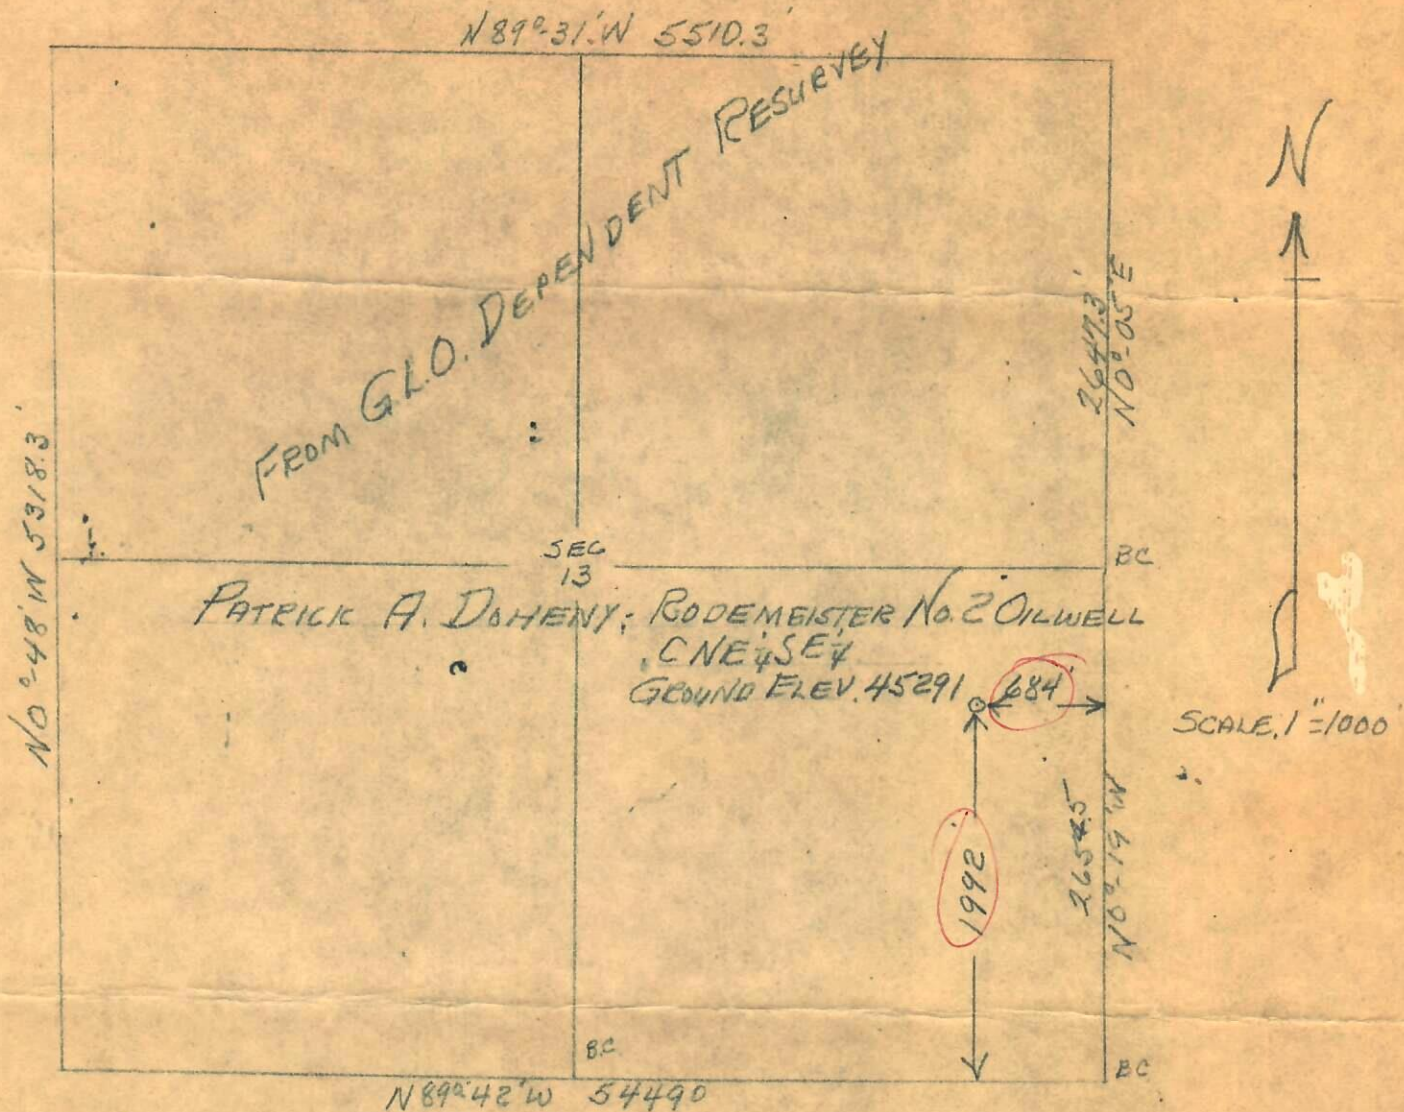

I hereby certify that the above plat is an accurate representation of a correct survey showing the location of Patrick A. Doheny-Rodemeister No. 2 Oilwell in C NE 1/4 SE 1/4 Sec. 13 T2N R54W 6PM. The elevation of the ground at the stake is 4529.1 feet above sea level from U.S.C. & G. bench Mark.

Fort Morgan, Colorado
Dec. 31, 1966

Raciel J. Osborne
Registered Professional Engineer
State of Colorado

66 539