


CERTIFICATE OF SURVEY
for
Patrick A. Doheny
Washington County, Colorado

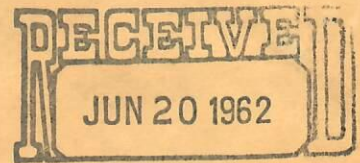


OIL & GAS
CONSERVATION COMMISSION



T2N R54W 6PM

N 89° 34' W 5510.3

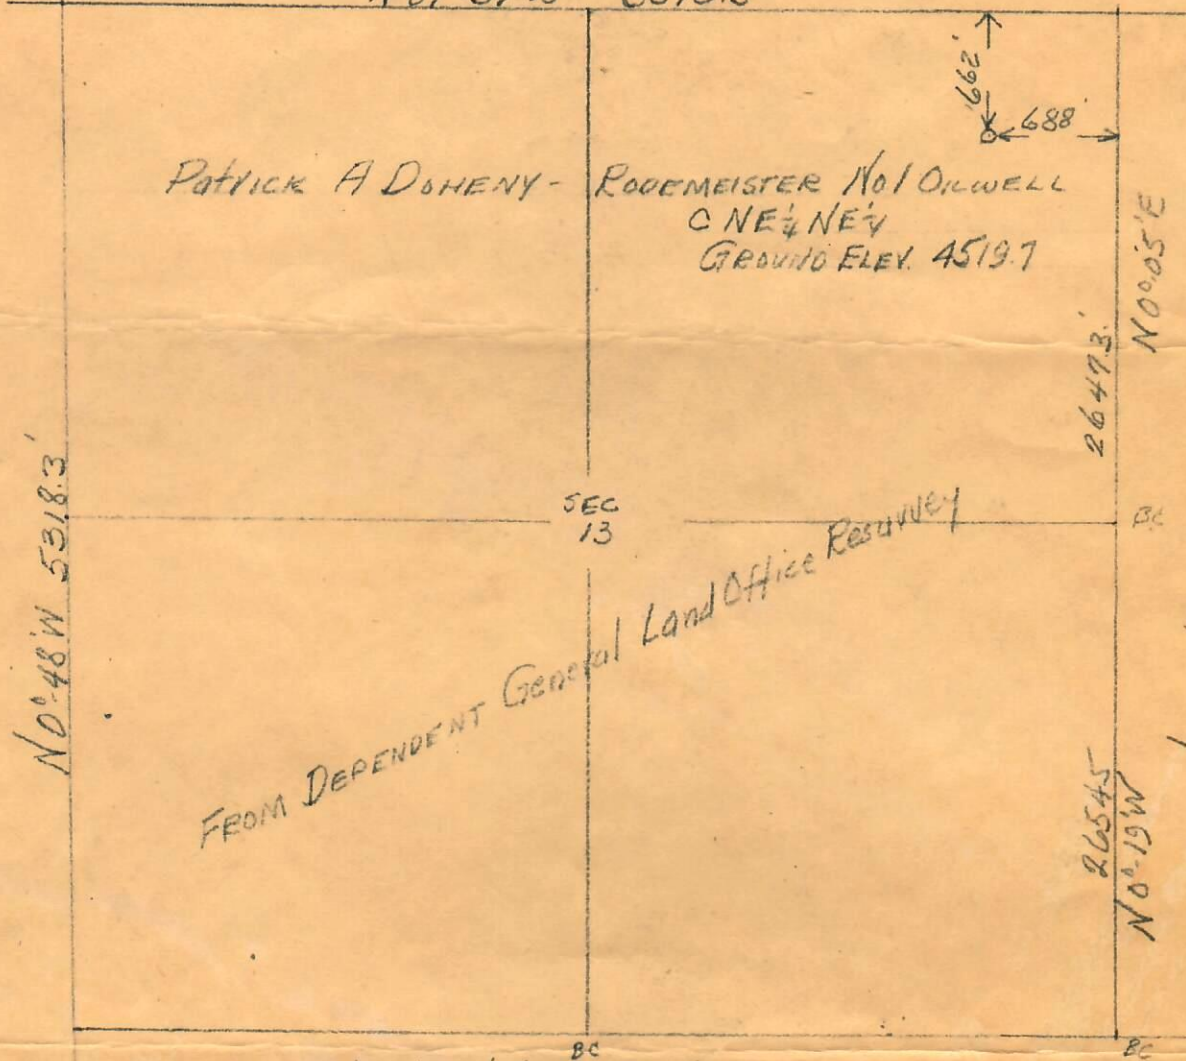

I hereby certify that the above plat is an accurate representation of a correct survey showing the location of Patrick A. Doheny-Roodmeister No. 1 Oilwell in C NE 1/4 NE 1/4 Sec. 13 T2N R54W 6PM. The elevation of the ground at the stake is 4519.7 feet above sea level from U.S.C.&G. Bench Mark.

Fort Morgan, Colorado
June 10, 1962

Beily Osborne
Registered Professional Engineer
State of Colorado.

13-2N-54W

