noble energy

Well Name & API: **ARENS G26-19, 05-123-30608**

Flowline Abandonment Type:

Partial Abandon in Place to area of conflict due to third-party pipeline crossings.

Note: With partial removal of DUPPER RG26-06 (05-123-12865) in common trench.

Flowlines
- Abandoned
- Active
- Out of Service
- Pre-commissioned
- Removed
- Turned into Air Line
- Area of Conflict (Proposed Abandon-in-Place Area)
- Proposed Soil Sample Location
- Field Screening Location

Wells
- Active
- Abandoned Location
- Dry & Abandoned
- Plugged & Abandoned
- Producing
- Shut-In
- Temporarily Abandoned

Third-Party Pipelines

- NWI Wetlands

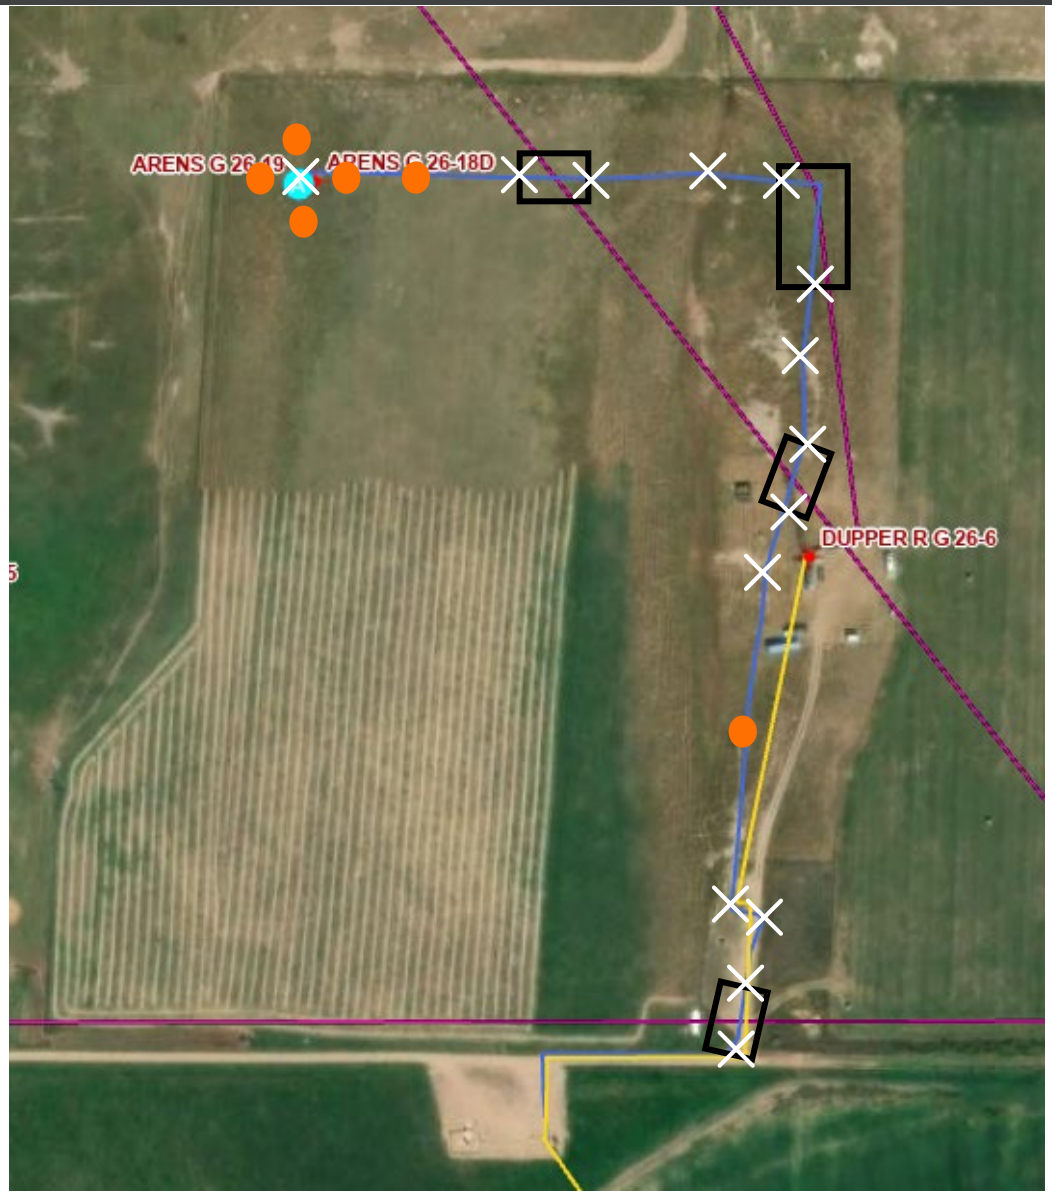

Well Latitude/Longitude: 40.286500/-104.635360
Flowline Length (ft): 2295

Flowline Point A Latitude/Longitude: 40.28297007/-104.6341447
Flowline Point B Latitude/Longitude: 40.28654/-104.63534

Created By: **Clara Jenck**
Date: **02/13/2024**