




00054451

CERTIFICATE OF SURVEY
for
Kingwood Oil Co.


T2N R54W 6PM

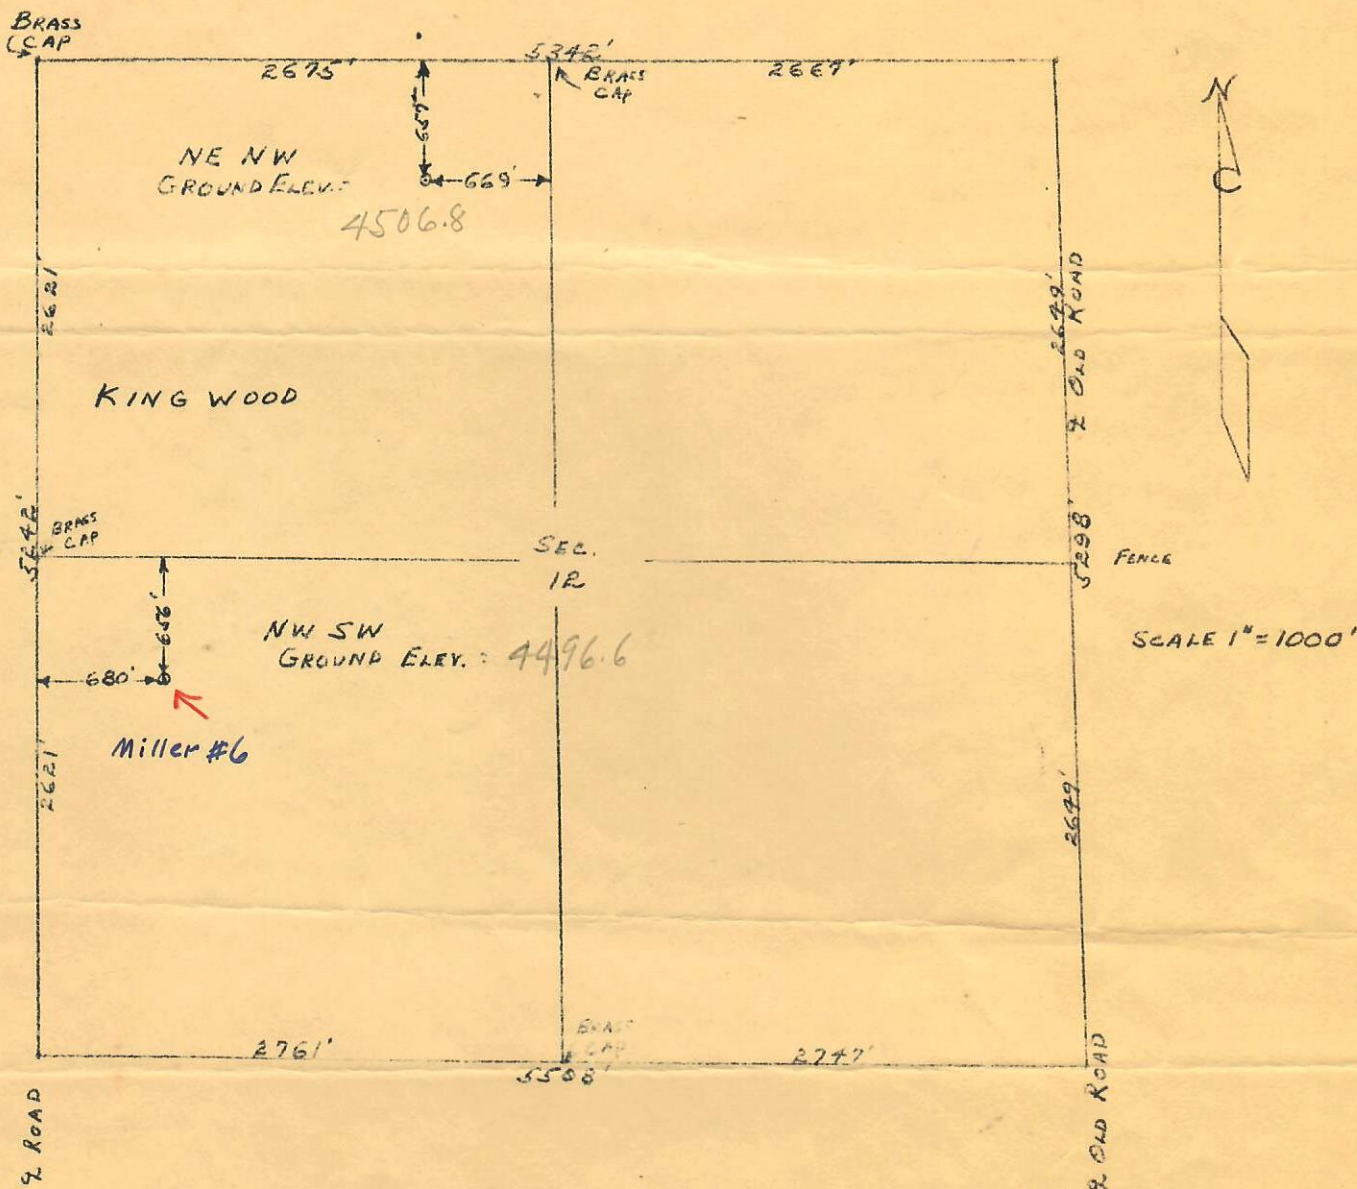

I hereby certify that the above plat is an accurate representation of a correct survey showing the location of Kingwood Oil Co.- Oilwells located in Sec. 12 T2N R54W 6 PM. NE NW; Ground elevation- 4506.8 feet; NW SW; Ground elevation- 4496.6 feet above sea level from U.S.C.G. Bench Mark.

Fort Morgan, Colorado
August 8, 1955

Registered Professional Engineer
State of Colorado

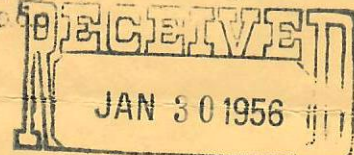

OIL & GAS
CONSERVATION COMMISSION