




00054452

COLORADO OIL AND GAS CONSERVATION COMMISSION
SUNDRY NOTICES AND REPORTS OF WELLS

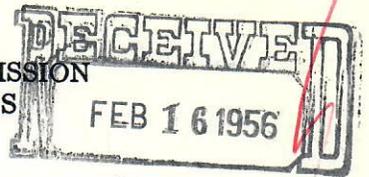

(Indicate nature of data by checking below)

- Notice of intention to drill (attach plat) _____
- Notice of intention to change plans _____
- Notice of date for test of water shut-off _____
- Report on result of test of water shut-off _____
- Notice of intention to re-drill or repair well _____
- Notice of intention to clean out well _____
- Statement of shooting _____
- Statement of perforating _____
- Notice to pull or otherwise alter casing _____
- Notice of intention to abandon well _____
- Report of work done on well since previous report _____
- Plugging Record _____

OIL & GAS
CONSERVATION COMMISSION

Locate Well Correctly

		12	
o			

Notice to do work Land: Fee and Patented
 Report of work done State Lease No. _____

Colorado State Washington County Xenia, West Field

6 (Well No.) J. M. Miller (Lease) NW SW (1/4 Sec.) 12 (Sec.) 2N (Twp.) 51W (Range) 6th (Meridian)

The Well is located 1965 Ft. (N) of Section Line and 680 Ft. (E) of Section Line. (S) (W)

The elevation above sea level is 4496.6 Ft., ground.

Details of Plan of Work: (State names of and expected depths to objective sands. Show sizes, weights, and length of proposed casings; indicate mudding jobs, cementing points, and all other important proposed work.)

Driller's T.D., 4849'. Schlumberger T.D., 4852'.

Plugged 2-7-56 as follows:

- Filled hole with heavy mud, 4852-293'.
- 10 sacks of cement, 293-245'.
- Mud 245-24'.
- 5 sacks of cement, 24' to surface.

AJJ	
DVR	
FJK	
WRS	
HHM	
AH	
JJD	<input checked="" type="checkbox"/>
...	

Approved: FEB 16 1956

A. J. Gossin
Director

Date February 13, 1956

Company Kingwood Oil Company 47875

Address Cravens Bldg., Okla. City, Okla.

By Ben Spain

Title Chief Clerk

Submit reports of proposed work, for approval, on this form in Duplicate for patented lands and in Triplicate for school and state lands.

T

