



FORM F-106



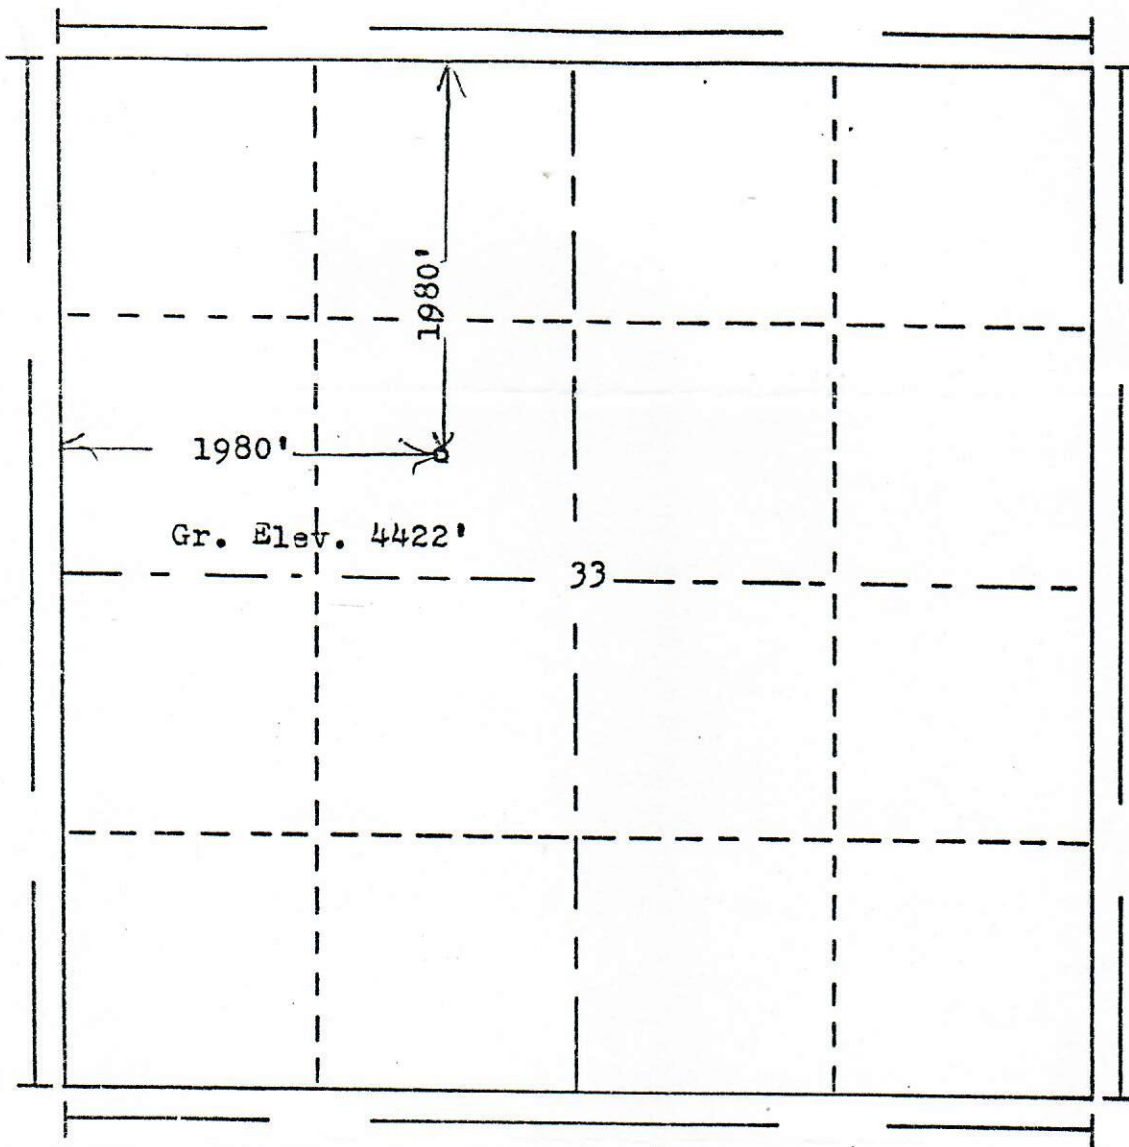
00091637

RECEIVED

NOV 20 1980

COLO. OIL & GAS CONS. COMM.

R. 56W

T.
2
N

Scale... 1" = 1000'

Powers Elevation of Denver, Colorado

has in accordance with a request from Mr. Cox
for Okmar Oil Co.

determined the location of No.1 Huey-Bederal
to be CSE NW Section 33 Township 2N
Range 56W of the 6th Principal Meridian
Morgan County, Colorado

I hereby certify that this plat is an
accurate representation of a correct
survey showing the location of

Date: 6-9-80

Bruce D. [Signature]
Licensed Land Surveyor No. 2853
State of Colorado