




RECEIVED

MAR - 9 1967

COLO. OIL & GAS CONS. COMM.

R. 56W

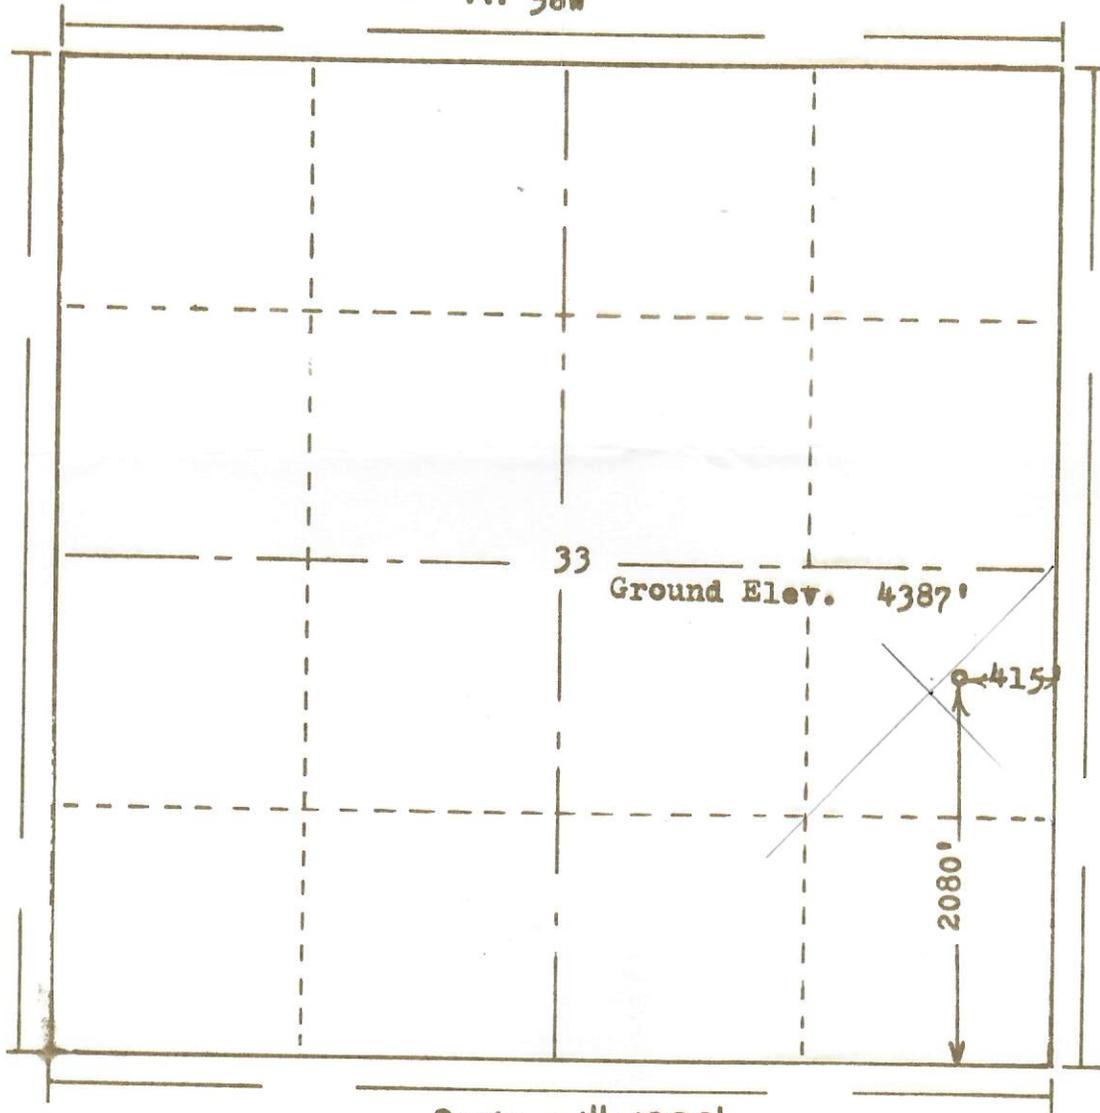

T.  
2  
N.

Scale ... 1" = 1000'

Powers Surveyors, Inc. of Denver, Colorado  
 has in accordance with a request from Mr. Harrison  
 for Cardinal Petroleum determined the  
 Location of No. 2 Federal-Stagecoach  
 to be 2080' FS & 415' FE Section 33 Township 2N  
 Range 56W of the 6th Principal Meridian  
 Morgan County, Colorado

67-90

I hereby certify that this plat is an accurate representation of a correct survey showing the location of

Date: 3-7-67

Brian D. Hollen  
 Licensed Land Surveyor No. 2853  
 State of Colorado