



**Holloway & Holloway, Inc.**  
 4218 W. 14th St. Lane  
 Greeley, CO 80634  
 (303) 867-3715  
 (303) 353-9747


R. 56W



N



pipe

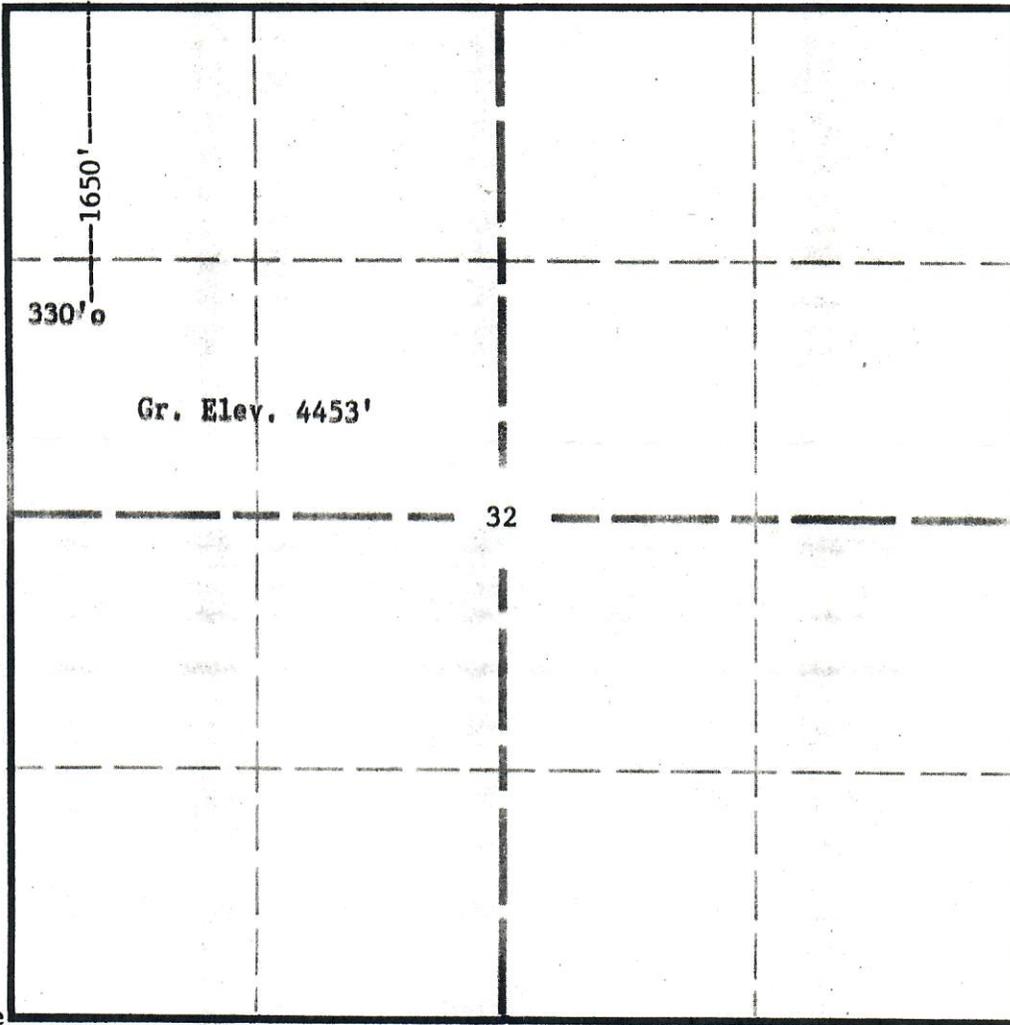

T.  
2  
N

Scale - - - 1" = 1000'

**RECEIVED**

In accordance with a request from Marexco  
 the Undersigned has  
 determined the location of the Huet 1-32  
 to be 1650' FNL & 330' FWL

JUN 26 1989

well  
**COLO. OIL & GAS CONS. COMM.**  
 as co-ordinates

**Section 32 Township 2N Range 56W of the 6th principal Meridian**  
**Morgan County, Colorado.**

I hereby certify,  
 that this oil and/or gas well location certificate was prepared for Marexco  
 that it is not a land survey plat or improvement survey plat, and that it is not to be relied upon for the  
 establishment of fence, building or other future improvement lines.

Date 6-23-89

*Brian J. Holloway*

**Holloway & Holloway, Inc.**  
**States of**  
**Colorado, Nebraska, Wyoming**