


087-05530

SE NW 35 2N 56W

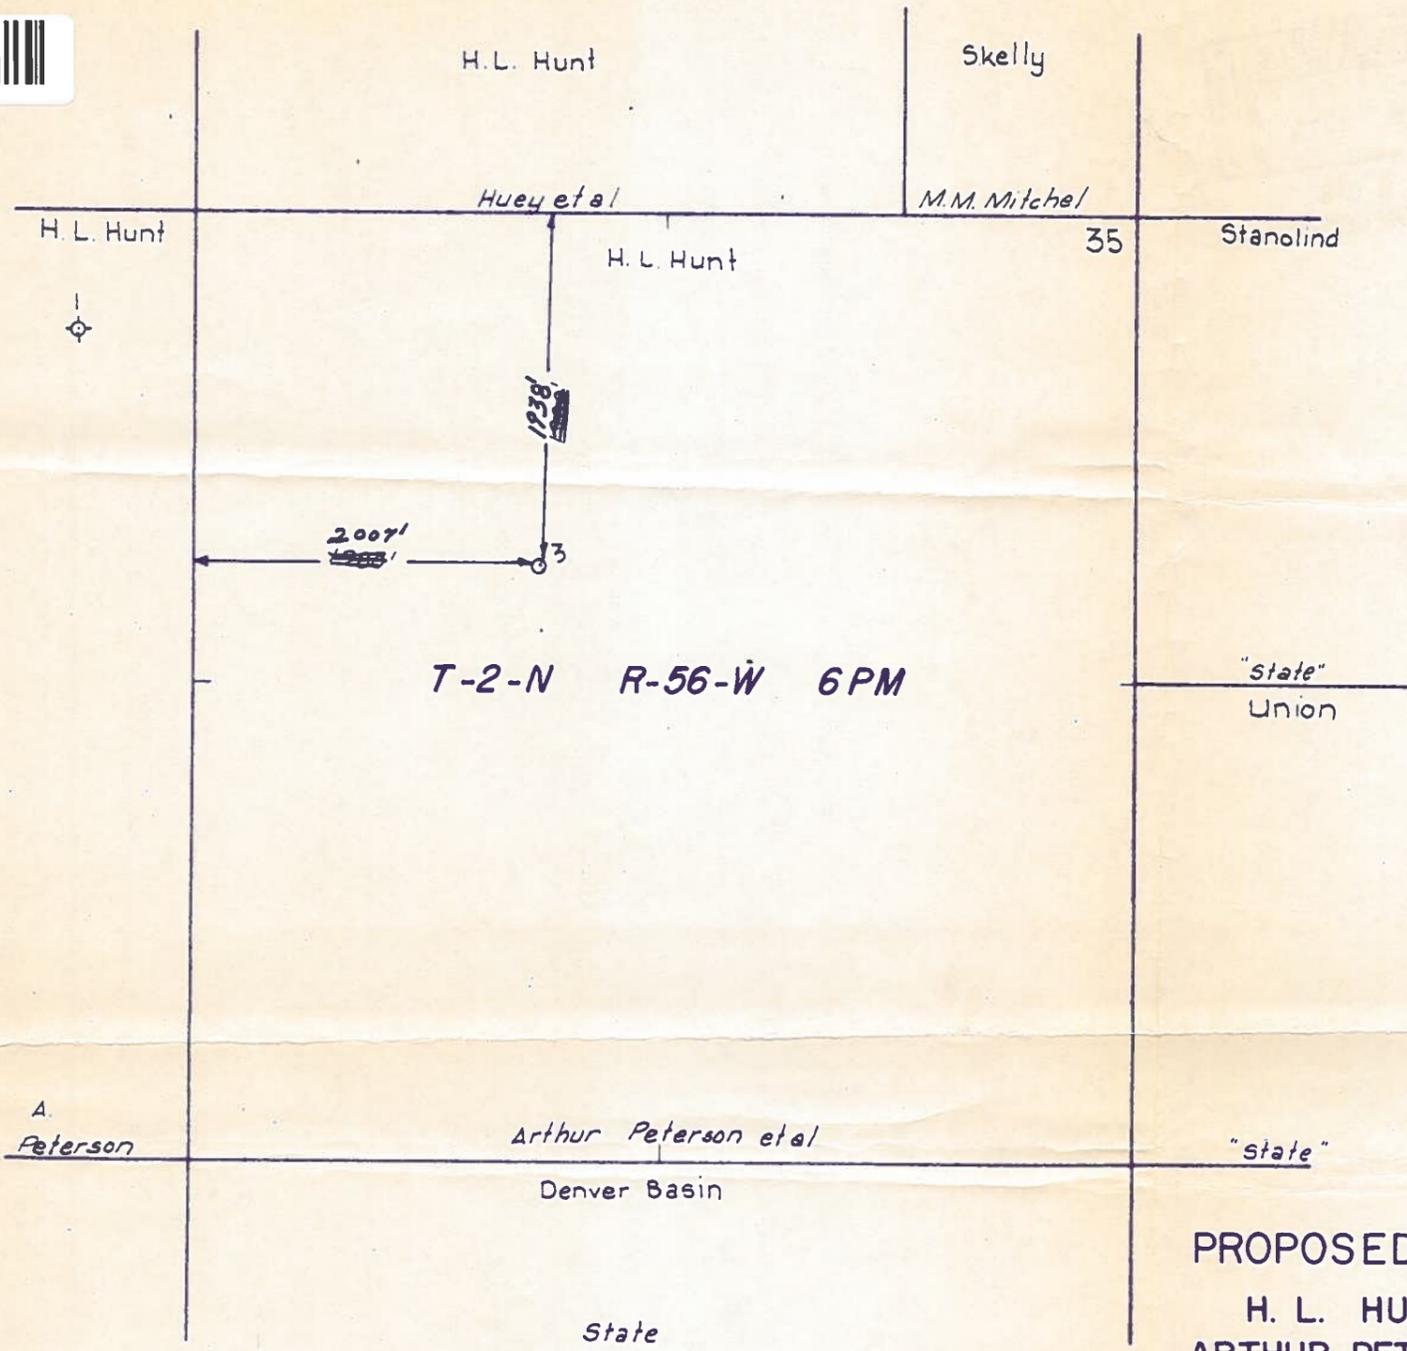

**PROPOSED LOCATION**  
**H. L. HUNT**  
**ARTHUR PETERSON NO. 3**  
**MORGAN CO, COLORADO**

THE STATE OF TEXAS:  
 COUNTY OF DALLAS:

I hereby certify that I am familiar with the conditions as they actually exist on this lease; that the above plat which is drawn to the scale indicated hereon is to the best of my knowledge true and correct; that it accurately reflects said lease with all wells thereon, and that the number and location of wells thereon are as indicated on the plat.

*B. N. Collis*  
 B. N. COLLIS

Subscribed and sworn to before me on this the 27 day of September, 1955.

*Helen Jackson*  
 Notary Public, Dallas County, Texas