


CERTIFICATE OF SURVEY
for
H.L.Hunt

OIL & GAS
CONSERVATION COMMISSION

T2N R56W 6PM.

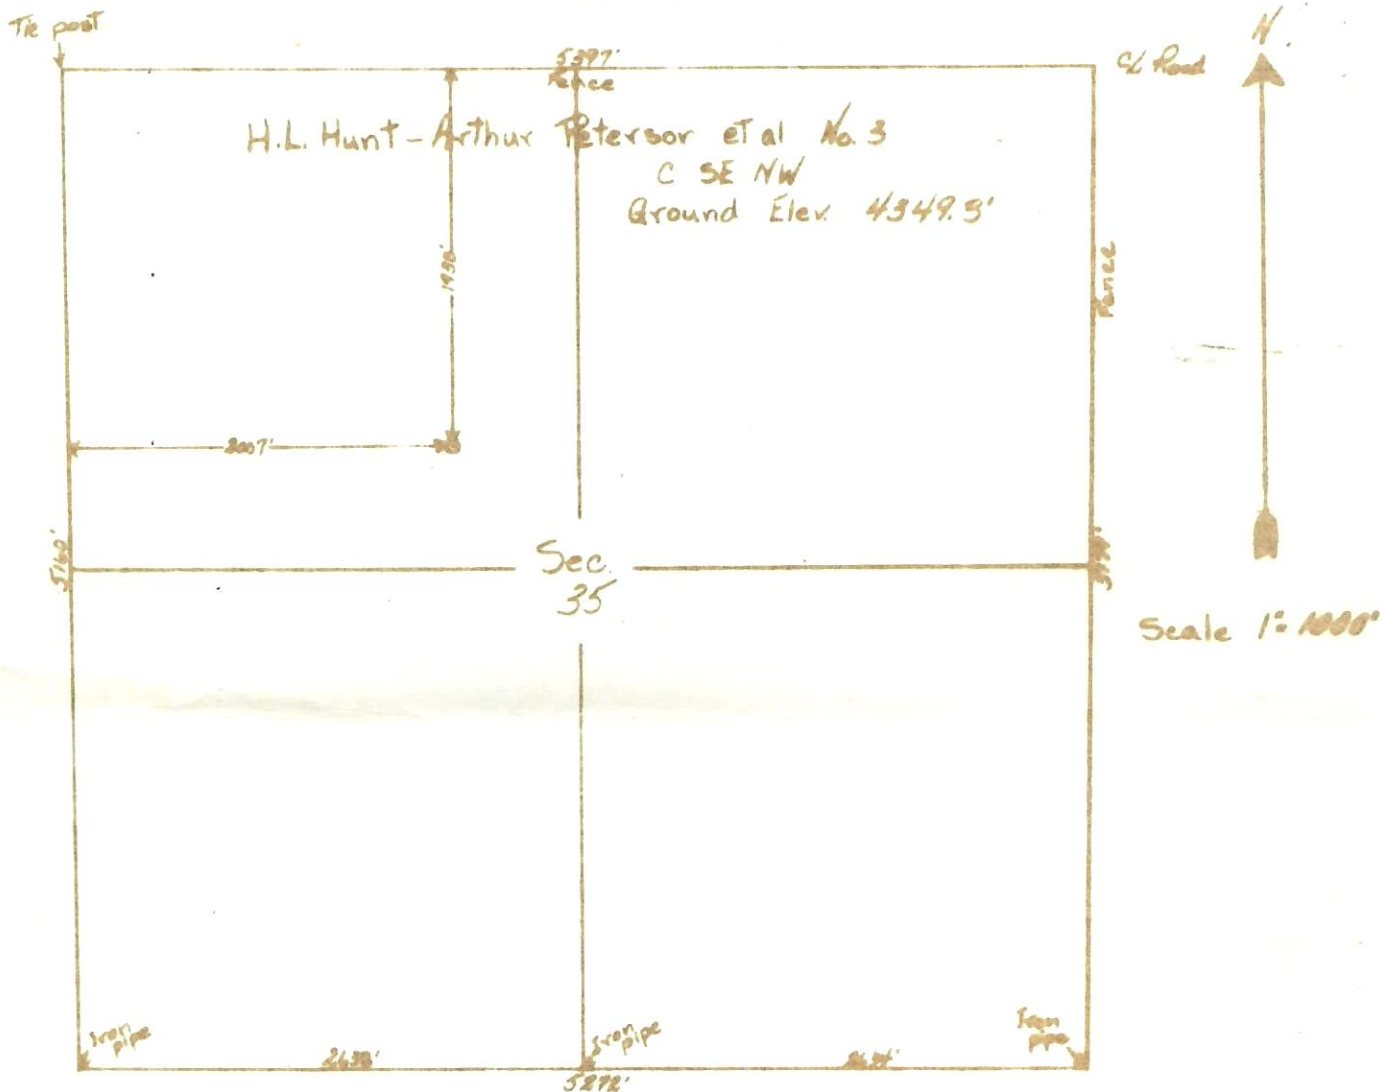

I hereby certify that the above plat is an accurate representation of a correct survey showing the location of H.L. Hunt-Peterson et al No. 3 Oilwell in C SE NW Sec. 35 T 2N R 56W 6PM. The elevation of the ground at the stake is 4349.3 feet above sea level.

Fort Morgan, Colorado
Oct. 3, 1955

Becil J. Johnson
Registered Professional Engineer
State of Colorado.