


# OIL AND GAS CONSERVATION COMMISSION OF THE STATE OF COLORADO

## NOTICE OF INTENTION TO DRILL

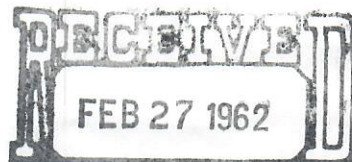

OIL & GAS  
CONSERVATION COMMISSION

### INSTRUCTIONS:

A notice of intention to drill a well shall be filed in duplicate on all Federal and Patented lands, and in triplicate on all State lands. Do not begin operations until approved copy has been received. It is mandatory that the proposed location comply with all rules and regulations of the Commission. Locate well on section grid in proper location, and indicate extent of lease. Unless operations are commenced within 180 days after the date of approval hereof, this approval to drill will become null and void.

Name of Operator H. L. Hunt Phone No. RI-1-3561  
Address 700 Mercantile Bank Building City Dallas State Texas

How is liability secured: Well Bond (Attached) ☐; Blanket Bond ☒; Waiver ☐  
(Check one)




00048382

Lease Name George E. Huey

Well No. 29

Field Name Wilcat ☒

County Morgan

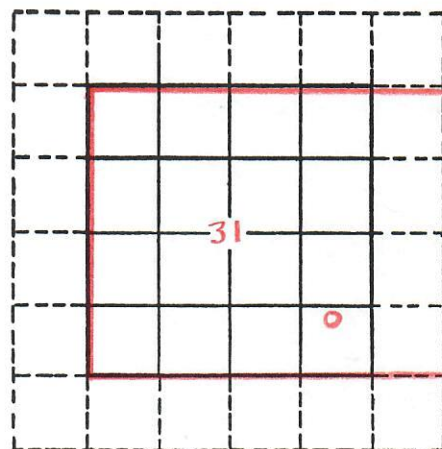

Location SW SW camp Section 31 Township 2-N Range 56-W Meridian 6  
(quarter quarter)  
990 feet from S Section line and 660 feet from E Section Line  
Nor S E or W

The well is located on: Patented land ☒ State land ☐ Federal land ☐

The well is located within a spaced area: Yes ☐ No ☒

Distance from proposed location to nearest property or lease line 660 feet.

Distance from proposed location to nearest drilling unit line 660 feet.

Objectives: "D" Depth 5400'; Formation Estimate Formation Depth Estimate

Proposed length of surface casing 110' feet.

### REMARKS:

Verbal approval for this well given Mr. C. E. Yancey February 22, 1962 per Mr. Jensen.

Agent	
Bond	<u>Blanket</u>
Spot	
600 ft.	
1200 ft.	
Wells	
Estimate	
Gas	
Status	

I/We hereby swear (or affirm) that the statements herein made are a full and correct report.

### APPROVED:

Date Feb 27 1962

[Signature]  
Director

Company H. L. HUNT Date February 26, 1962

Address 700 Mercantile Bank Bldg. Phone No. RI-1-3561  
Dallas, Texas

By [Signature] Title Asst. Petroleum Eng.  
B. N. Collis Signature