API:	**05-123-08586**	**CREATED BY:**	**C. MARTIN**	**DATE:**	**Mar 13, 2024**
WELL NAME:	**FRANK 1**	**ELEVATION:**	**4913**	**QTRQTR:**	**NENE**
COUNTY:	**WELD**	**GROUND LEVEL:**	**4903**	**SEC:**	**33**
LATITUDE:	**40.273295**	**MD:**	**7852**	**TWN:**	**4N**
LONGITUDE:	**-104.888564**	**PBMD:**	**7805**	**RNG:**	**67W**

Existing DATUM: RKB **Existing**

KB=10'

Hole Size/Depth 12-1/4" / 339'

10 sx cmt to surface

63' BOC

300 Sx Cmt

Surface Casing 8-5/8", 24#, J-55 set @ 339'

25 sx 304' Est TOC

375' BOC

Deepest water well in 1 mile - 590'

Upper Pierre Aquifer Base 1210'

Sussex Top 4125'

Csg cut/pull 6700'

Niobrara Top 6940'

TOC (from CBL) 7018'

290 Sx Cmt

Production Casing 4-1/2", 11.6#, I-80 set @ 7850'

Hole Size/Depth 7-7/8" / 7852'

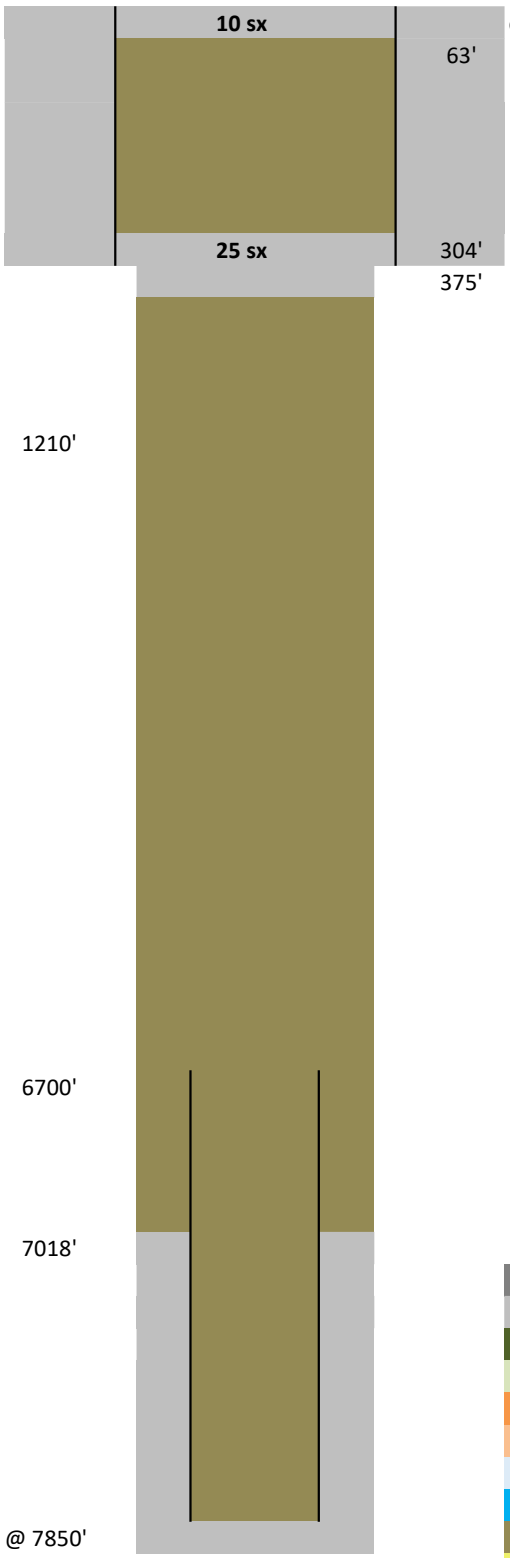

New Cement
Existing Cement
New CICR
Existing CICR
New CIBP
Existing CIBP
Treated Water
Brine
Mud
Sand Plug