
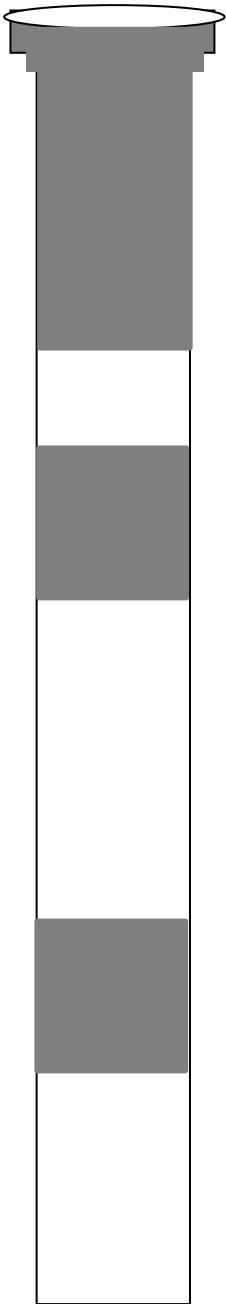


Magpie Operating Inc

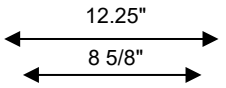

TD 5530'

General Well Info			
Well Name:	Henry Weber #1	Field:	Loveland
Diagram Date:	3/15/2024	County:	Larimer
Srf Location:	NENE 25 5N 69W	State:	Colorado
Lease #(/BLM):		API #:	05-069-05067
GL Elev:	4917'		
Formation Tops			
Zone	Depth	Zone	Depth
Niobrara	4400'	Dakota	5370'
Codell	4675'	Lakota	5483'
Muddy	5150'	Morrison	5525'

Srf Csg 12 1/4" hole, 8 5/8" k55, 23# @ 207'

Cmt 175 sx at 211' to surface

Cement Plug @ 303' w/ 150 sx cmt

Cement Plug @ 1020' w/ 100 sx cmt

Actual P&A

Cement Plug @ 4,201' w/ 50 sx

Cement Plug @ 2,015' w/ 50 sx

Cement Plug @ 1,020' w/ 100 sx

Cement Plug @ 303' w/ 150 sx

Cement Plug @ 2015' w/ 50 sx cmt

Cement Plug @ 4201' w/ 50 sx cmt