


CERTIFICATE OF SURVEY
for
Gear Drilling Co.
Washington County, Colorado



00066635

T2N R53 W6PM

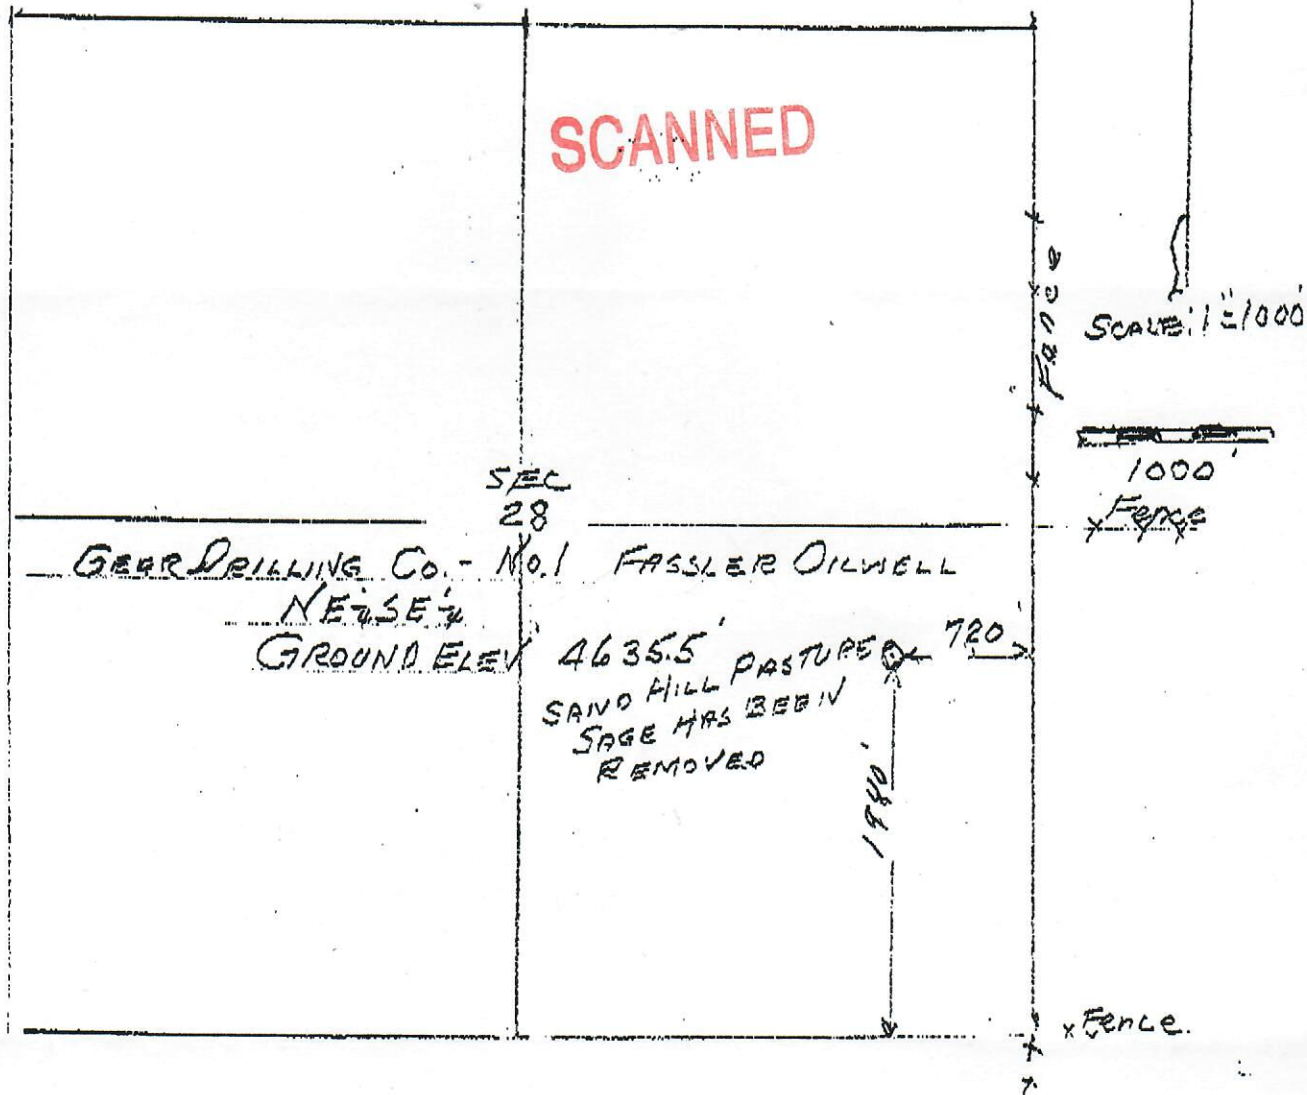

I hereby certify that the above plat is an accurate representation of a correct survey showing the location of Gear Drilling Co.-No.1 Fassler Oilwell in NE 1/4 Sec. 28 T2N R53W 6PM. The elevation of the ground at the stake is 4635.5 feet above sea level from U.S.G.S. Bench Mark.

Fort Morgan, Colorado
June 9, 1993

Registered Professional Engineer
State of Colorado

