



FORM F-106



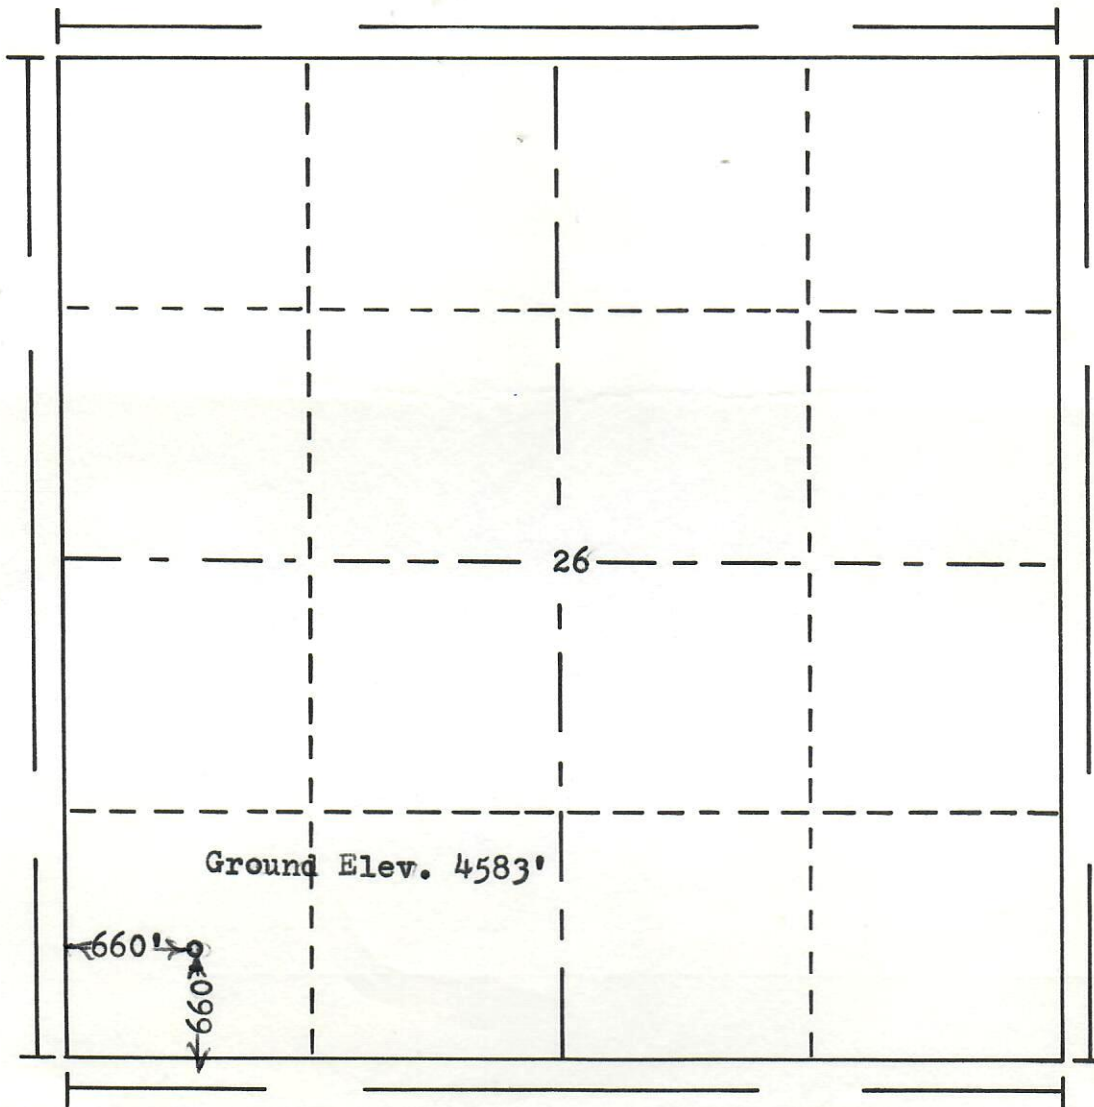
00064641

RECEIVED

JAN 6 1972

SCANNED

R. 52W. 01 & 013. COMM.

T.
2
N

Scale... 1" = 1000'

71-1041

Powers Elevation Company, Inc. of Denver, Colorado
has in accordance with a request from Michelle
for Jack G. Ladner & Exeter Drlg. & Exploration Co.
determined the location of No.1 Allen
to be CSW SW Section 26 Township 2N
Range 52W of the 6th Principal Meridian
Washington County, Colorado

I hereby certify that this plat is an
accurate representation of a correct
survey showing the location of

Date: 12-30-71

B. J. Hallway
Licensed Land Surveyor No. 2853
State of Colorado