


C & J FIELD SERVICE

WELL NAME           LEBAUER 5  
ACTUAL  
LEGAL LOCATION    SEC 10, T1N, R102W, NENW, 6TH PM  
API NUMBER        05-103-07121  
COUNTY            RIO BLANCO  
DATE OF DIAGRAM    6/24/2022  
LEASE                COC034894

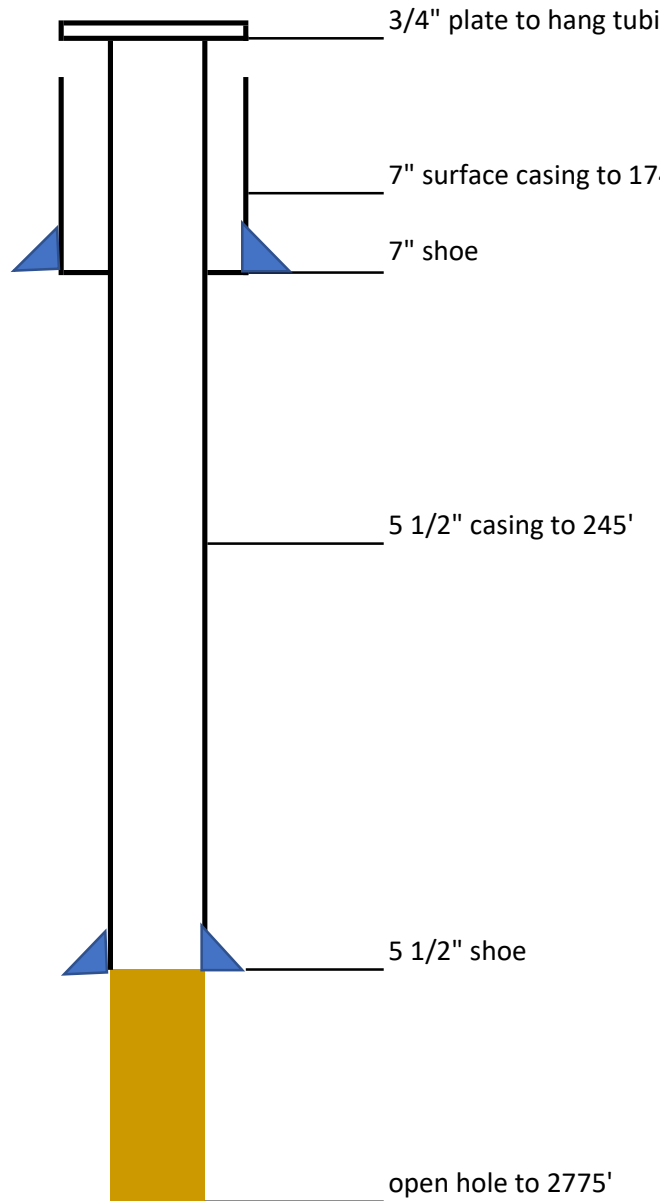

ng

4'