


CERTIFICATE OF SURVEY
for
Holly Resources Corp.
Washington County, Colorado

RECEIVED

DEC 20 1968

SCANNED
COLD. OIL & GAS CONS. COMM.

T2N R54W 6PM

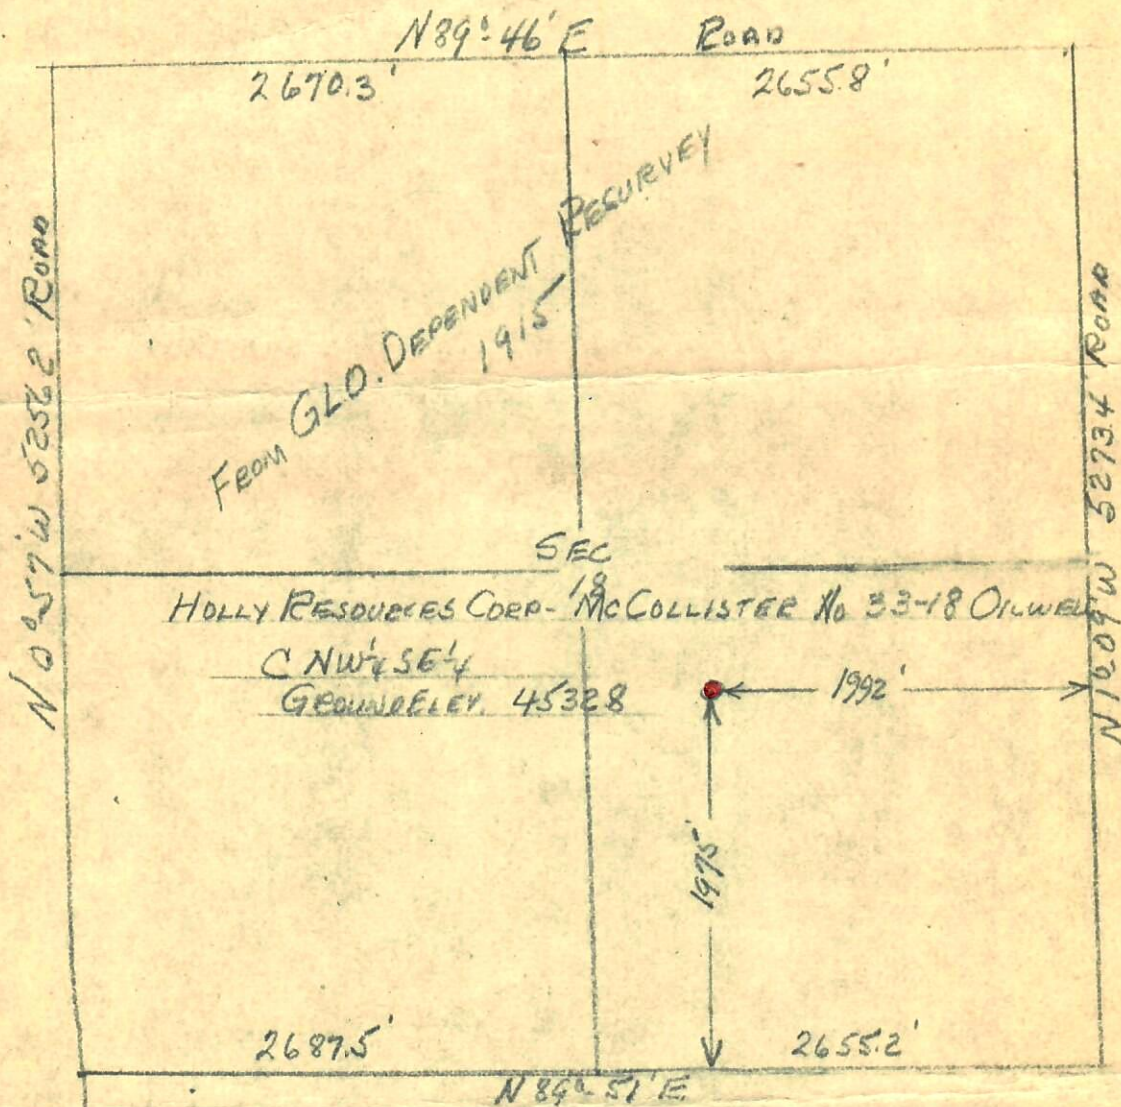

I hereby certify that the above plat is an accurate representation of a correct survey showing the location of Holly Resources Corp. - McCollister No. 33-18 Oilwell in C NW 1/4 SE 1/4 Sec. 18 T2N R54W 6PM. The elevation of the ground at the stake is 4532.8 feet above sea level from U.S.C.&G. Bench Mark.

Fort Morgan, Colorado
Dec. 15, 1968

Bevil J. Osborne
Registered Professional Engineer
State of Colorado

68-532