

OIL AND GAS CONSERVATION COMMISSION
OF THE STATE OF COLORADO

NOTICE OF INTENTION TO DRILL



INSTRUCTIONS:


SCANNED

A notice of intention to drill a well shall be filed in duplicate on all Federal and Patented lands, and in triplicate on all State lands. Do not begin operations until approved copy has been received. It is mandatory that the proposed location comply with all rules and regulations of the Commission. Locate well on section grid in proper location, and indicate extent of lease. Unless operations are commenced within 180 days after the date of approval hereof, this approval to drill will become null and void.

Name of Operator Plains Exploration Company 70500 Phone No. CH 4-7431
Address 1135 Petroleum Club Bldg. City Denver 2, State Colorado

How is liability secured: Well Bond (Attached) ☐; Blanket Bond ☐; Waiver ☒
(Check one)

Lease Name Mitchell "B" Lease L-2647
Well No. Mitchell "B" #1
Field Name Ruby Story Point Wildcat ☐
County Washington County, Colorado

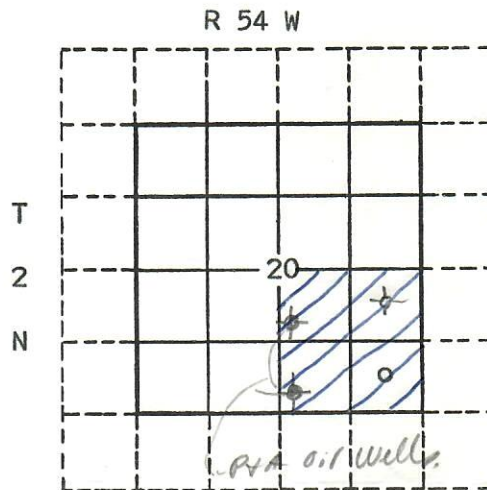

Location C SE SE (quarter quarter) Section 20 Township 2 N Range 54 W Meridian 6th P.M.
Approx 660 feet from S Section line and 660 feet from E Section Line
N or S E or W

The well is located on: Patented land ☒ State land ☐ Federal land ☐

The well is located within a spaced area: Yes ☐ No ☒

Distance from proposed location to nearest property or lease line 660 feet.
Distance from proposed location to nearest drilling unit line 660 feet.

Objectives: "D" Sand Depth 4800' ; "J" Sand Depth 4860'
Formation Estimate Formation Estimate

Proposed length of surface casing 150 feet. Of 8-5/8" set with 125 sack cement.

REMARKS:

Approximate total depth 4950'

Ground elevation will be sent when available.

Agent	<u>RP</u>
Bond	<u>waived</u>
Spot	
600 ft.	<input checked="" type="checkbox"/>
1200 ft.	<input checked="" type="checkbox"/>
Wells	
Oil	
Gas	
Status	

I/We hereby swear (or affirm) that the statements herein made are a full and correct report.

APPROVED:

Date FEB - 5 1960

R. J. Persim
Director

Company Plains Exploration Co. Date 2.3.60
1135 Petroleum Club Bldg.
Address Denver 2, Colorado Phone No. CH 4-7431
By Russell H. Volk Title President
Signature