

CERTIFICATE OF SURVEY
for
H.L. Hunt
Morgan County, Colorado

RECEIVED
SEP 12 1963




99999999

08705612

OIL & GAS
CONSERVATION COMMISSION

T2N R56W 6PM

SCANNED

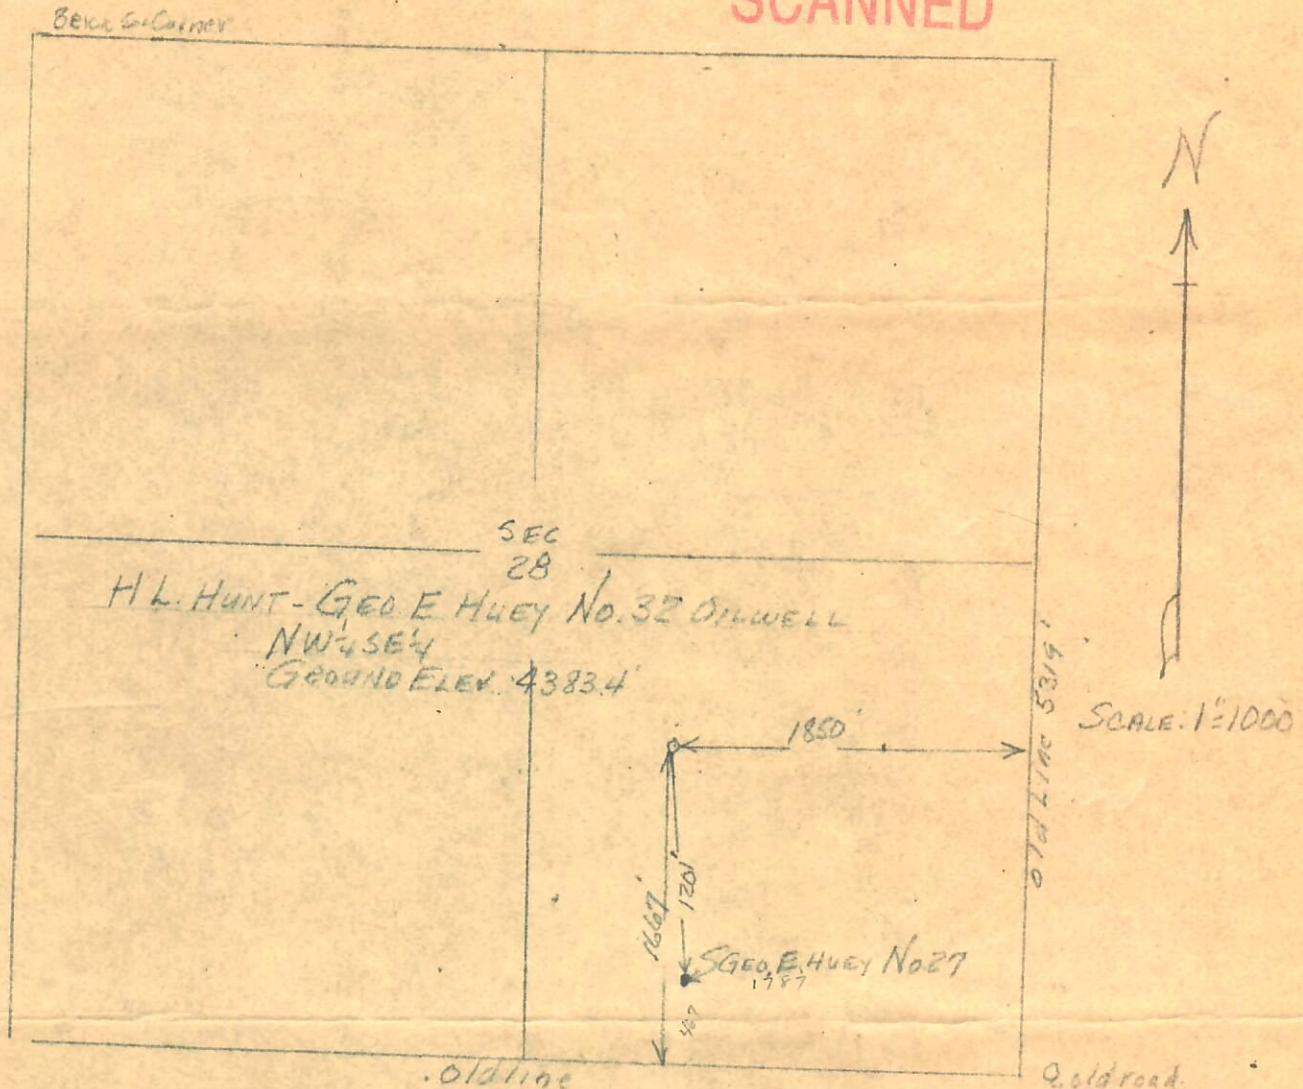

I hereby certify that the above plat is an accurate representation of a correct survey showing the location of H.L. Hunt-Geo. E. Huey No. 32 Oilwell in NW 1/4 SE 1/4 Sec. 28 T2N R56W 6PM. The elevation of the ground at the stake is 4383.4 feet above sea level from U.S.B.R. bench Mark.

Fort Morgan, Colorado
Aug. 31, 1963

Cecil J. Osborne
Registered Professional Engineer
State of Colorado.



00104931