

79-3




CERTIFICATE OF SURVEY  
for  
Patrick A. Doheny  
Washington County, Colorado

RECEIVED  
JAN 10 1979

COLO. OIL & GAS CONS. COMM.

T2N R53W6PM

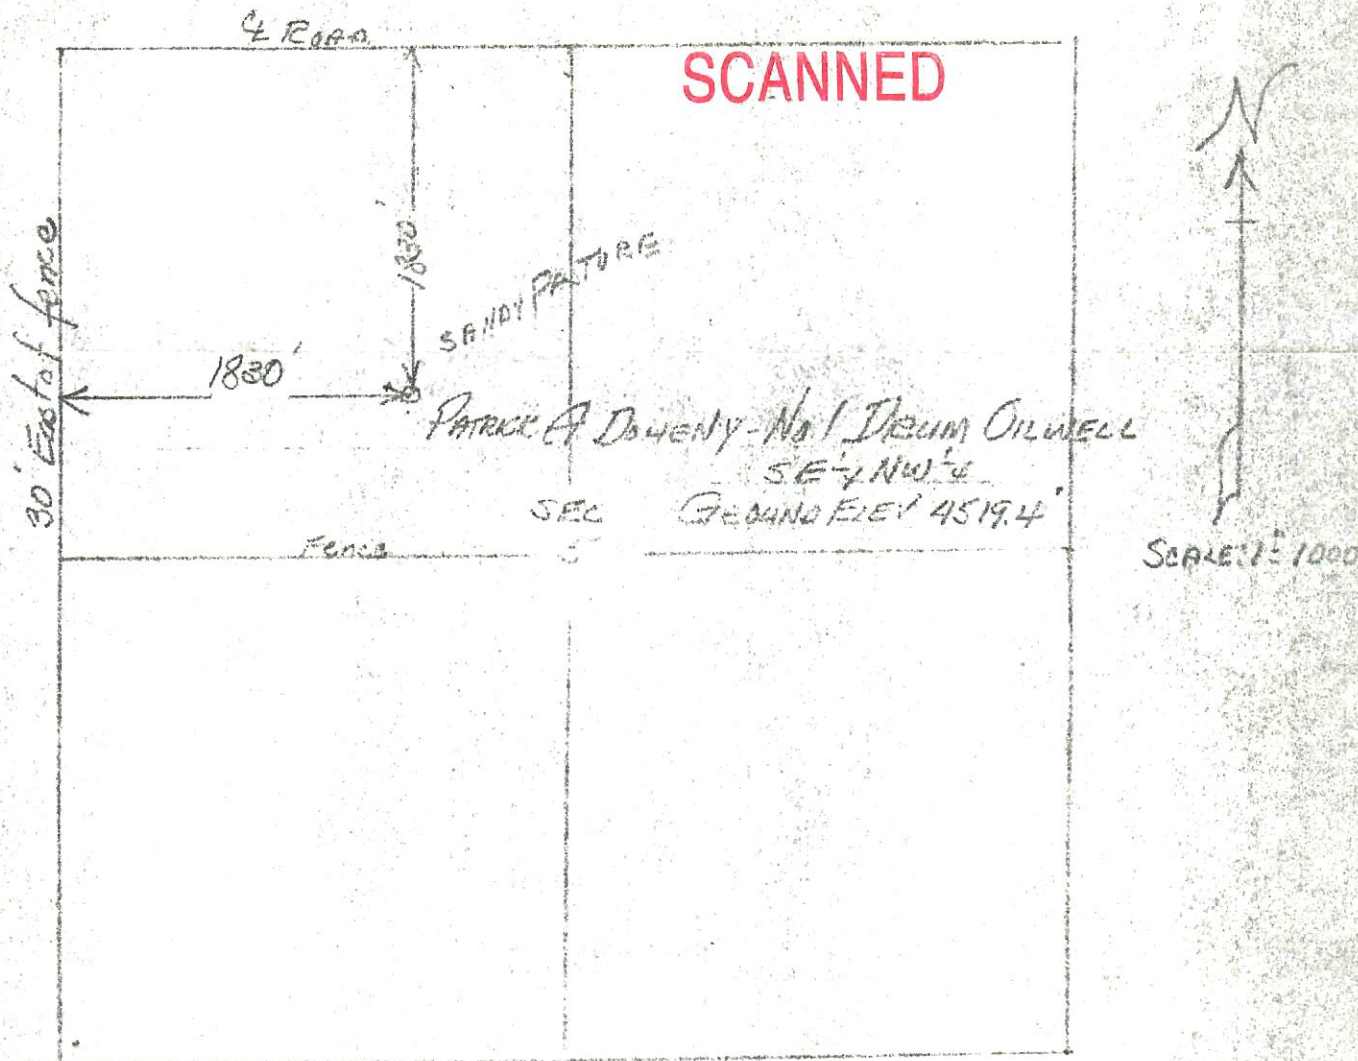

I hereby certify that the above plat is an accurate representation of a correct survey showing the location of Patrick A. Doheny-No. 1 2-A Drum Oilwell in SE 1/4 NW 1/4 Sec. 5 T2N R53W 6PM. The elevation of the ground at the stake is 4519.4 feet above sea level from U.S.G.S. BenchMark.

Fort Morgan, Colorado  
Jan. 2, 1979

*Becil J. Osborne*  
Registered Professional Engineer  
State of Colorado

# 2-A DRUM