




RECEIVED
SEP 1 1965
OIL & GAS
CONSERVATION COMMISSION

R. 56W

2580'

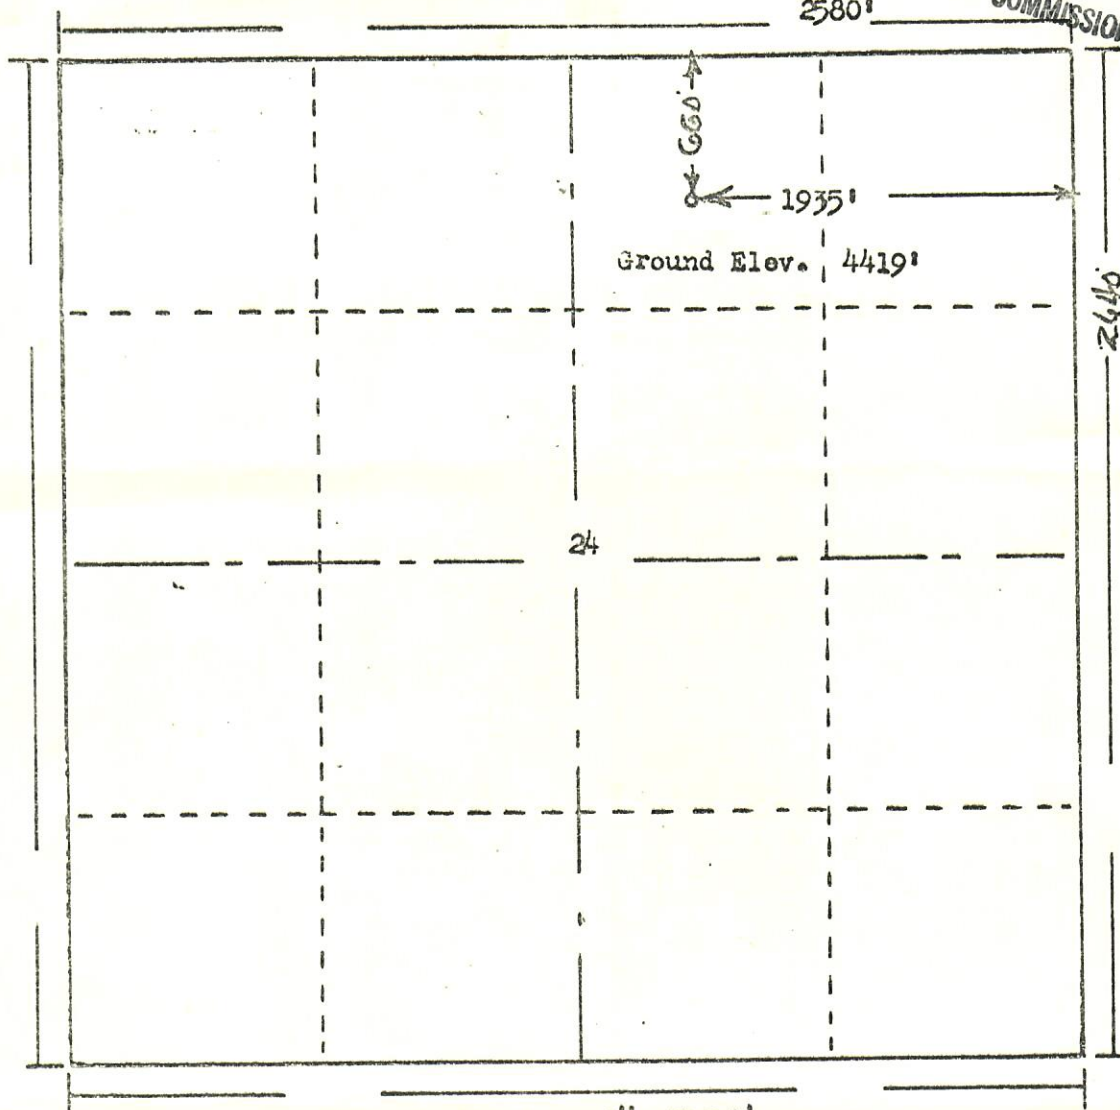

T.
9
N

Scale ... 1"=1000'

Powers Surveyors, Inc. of Denver, Colorado
has in accordance with a request from Mrs. Gossert
for Stueco Oil & Buttes Gas & Oil Co. determined the
Location of No. 2 J. Nickles
to be CNW NE Section 24 Township 9N
Range 56W of the 6th Principal Meridian
Weld County, Colorado

I hereby certify that this plat is an
accurate representation of a correct
survey showing the location of

Date: Aug 31 1965

Erin G. Hallway
Licensed Land Surveyor No. 8853
State of Colorado