



99999999


Date of Plat March 8, 1955

Logan County, Colorado

Township 9 North Range 55 West

07506265

No. 912.—The Bradford-Robinson Ptg. Co., Mfrs. Robinson's Legal Blanks, Denver

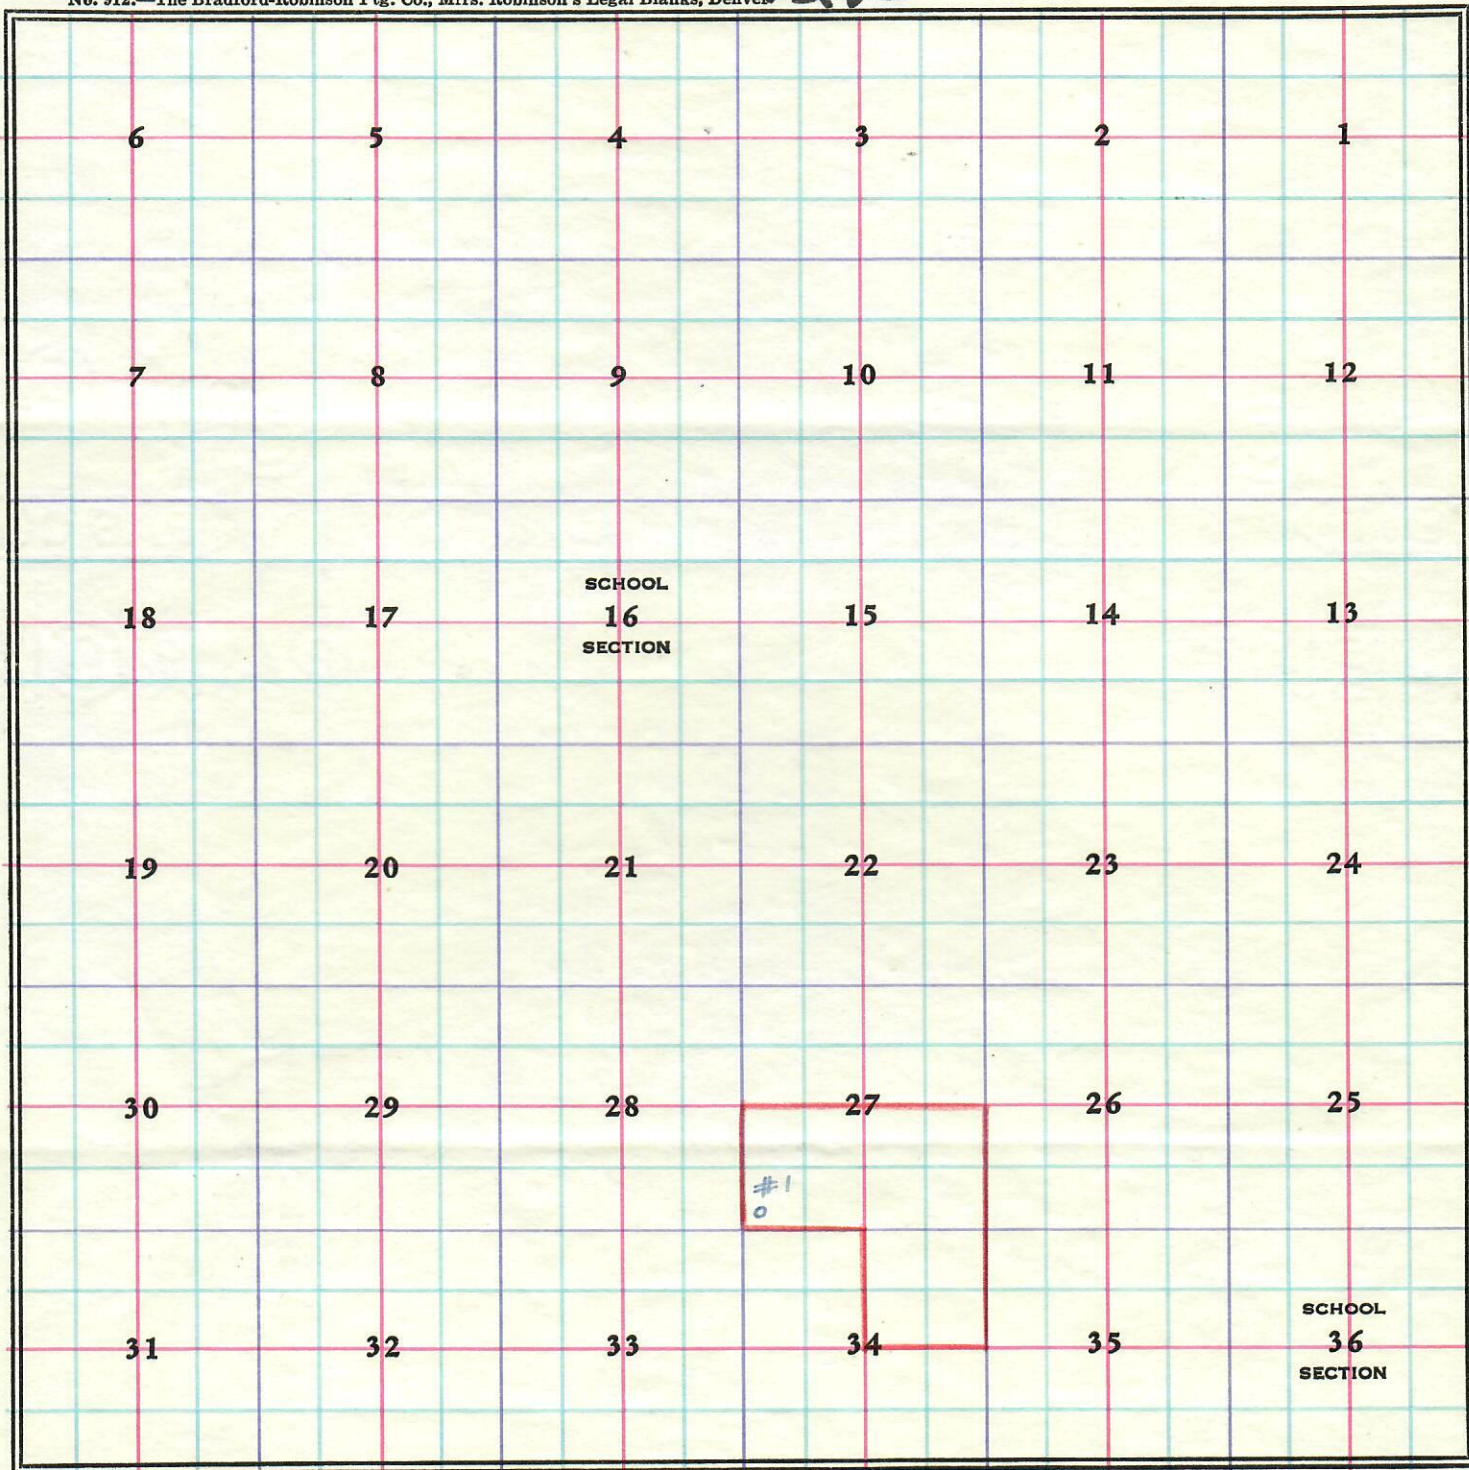

RECEIVED
MAR 9 1955

OIL & GAS
CONSERVATION COMMISSION



00819200

SCALE.
32 chains to one-half inch.