


**T2N, R97W,  
6th P.M.**

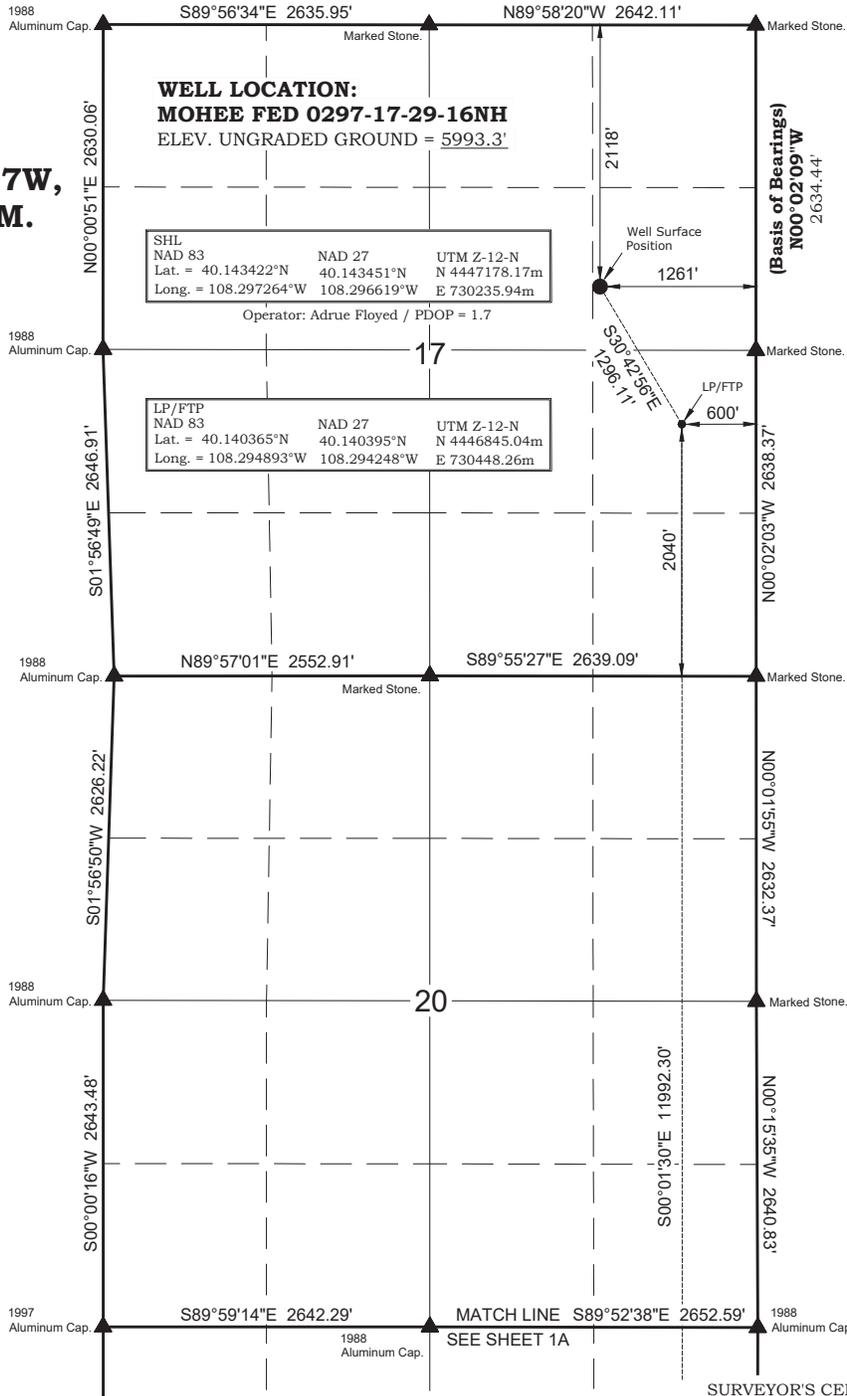


**NOTES:**

- ▲ = Section Corners Located
- △ = Section Corners Located Not Monumented
- 1. Well footages are measured at right angles to the Section Lines.
- 2. Bearings and distances shown on this plat are based upon a local Cartesian Grid which is oriented to Geodetic North at the SE Corner of Section 36, T2N, R97W, 6th P.M. The grid having a mean project height of 6,250'. Lineal units used are U.S. Survey Foot. Trimble G.P.S. equipment was used in performance of this survey.
- 3. Latitude and Longitude are NAD 83 (2011) Epoch 2010. Elevations are NAVD 88. Which are derived from an NGS OPUS Report.

**ANSCHUTZ  
EXPLORATION CORPORATION**  
555 17th Street, Suite 2400 - Denver, Colorado 80202

**WELL PLAT**

**MOHEE FED 0297-17-29-16NH  
600' FSL & 600' FEL (Bottom Hole)  
SE ¼ SE ¼ OF SECTION 29, T2N, R97W,  
6th P.M., RIO BLANCO COUNTY, COLORADO**

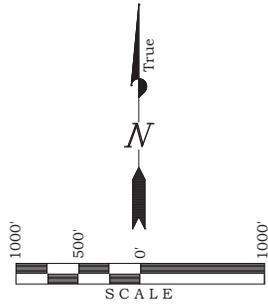


**SURVEYOR'S CERTIFICATE**  
I, BROCK J. SLAUGH, DO HEREBY CERTIFY THAT I AM A PROFESSIONAL LAND SURVEYOR AND THAT I HOLD CERTIFICATE #38443 AS PRESCRIBED BY THE LAWS OF THE STATE OF COLORADO. I FURTHER CERTIFY THAT THIS PLAT AND ITS COMPUTATIONS AND FIELD SURVEYS NECESSARY FOR THE DATA COMPILED HEREON WERE MADE BY ME OR UNDER MY SUPERVISION AND THE SAME ARE TRUE AND CORRECT TO THE BEST OF MY KNOWLEDGE AND BELIEF; THAT THE SURVEY WAS PERFORMED IN ACCORDANCE WITH APPLICABLE STANDARDS OF PRACTICE AND I AM NOT PROVIDING A GUARANTY OR WARRANTY, EITHER EXPRESSED OR IMPLIED, THIS CERTIFICATE DOES NOT REPRESENT A LAND SURVEY PLAT OR IMPROVEMENT SURVEY PLAT AS DEFINED BY C.R.S. § 5-1-102 AND CANNOT BE RELIED UPON TO DETERMINE OWNERSHIP.




<b>TIMBERLINE</b>		
ENGINEERING & LAND SURVEYING, INC. 209 NORTH 300 WEST - VERNAL, UTAH 84078		
DATE SURVEYED: 7-11-23	SURVEYED BY: C.S.	SHEET
DATE DRAWN: 8-29-23	DRAWN BY: S.A.	<b>1</b>
SCALE: 1" = 1000'	Date Last Revised: 9-27-23 S.A.	OF 39

**T2N, R97W,  
6th P.M.**

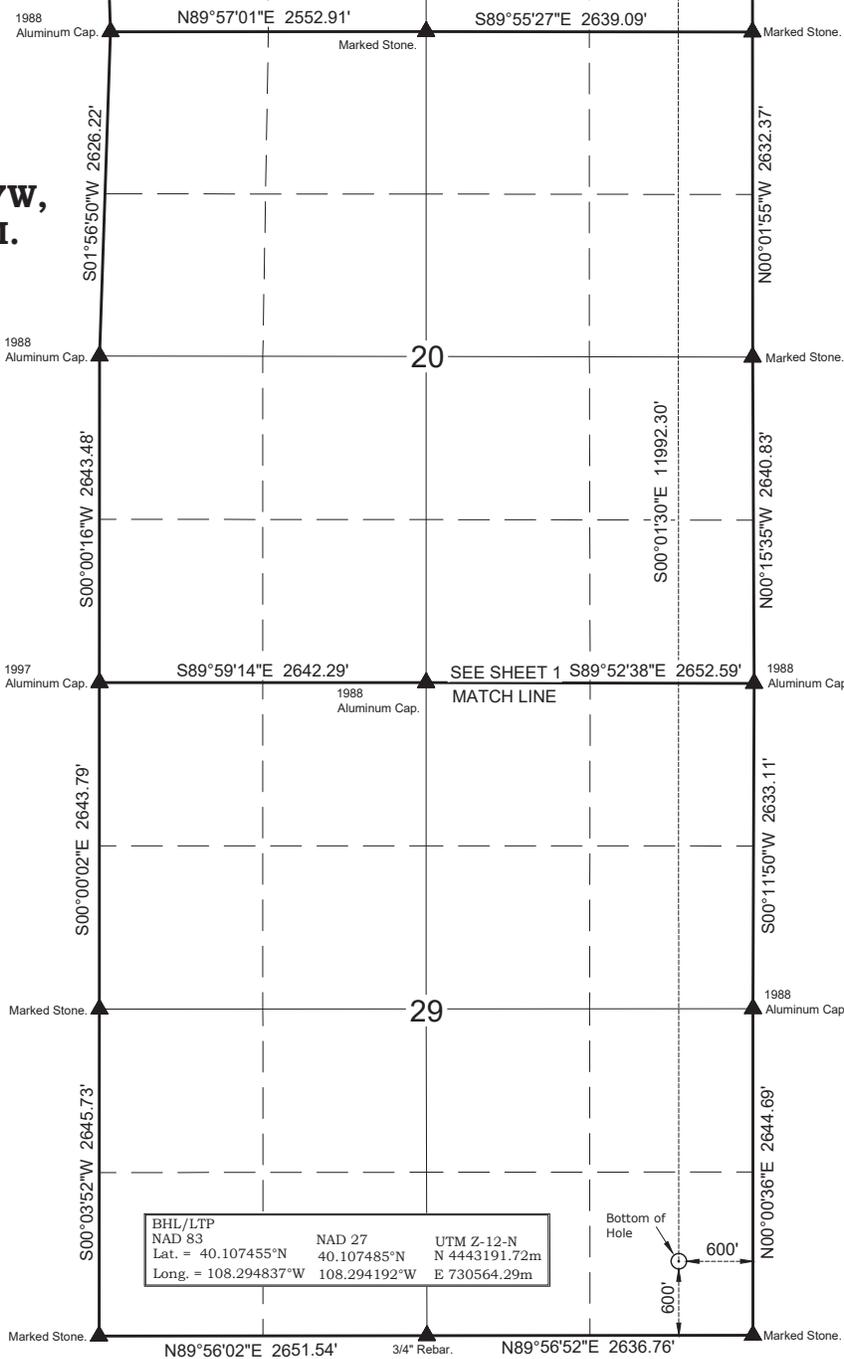

BHL/LTP  
 NAD 83                      NAD 27                      UTM Z-12-N  
 Lat. = 40.107455°N      40.107485°N      N 4443191.72m  
 Long. = 108.294837°W    108.294192°W    E 730564.29m

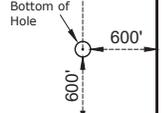


**NOTES:**

- ▲ = Section Corners Located
- △ = Section Corners Located Not Monumented
- 1. Well footages are measured at right angles to the Section Lines.
- 2. Bearings and distances shown on this plat are based upon a local Cartesian Grid which is oriented to Geodetic North at the SE Corner of Section 36, T2N, R97W, 6th P.M. The grid having a mean project height of 6,250'. Lineal units used are U.S. Survey Foot. Trimble G.P.S. equipment was used in performance of this survey.
- 3. Latitude and Longitude are NAD 83 (2011) Epoch 2010. Elevations are NAVD 88. Which are derived from an NGS OPUS Report.

**ANSCHUTZ**  
**EXPLORATION CORPORATION**  
 555 17th Street, Suite 2400 - Denver, Colorado 80202

**WELL PLAT**

**MOHEE FED 0297-17-29-16NH**  
**600' FSL & 600' FEL (Bottom Hole)**  
**SE ¼ SE ¼ OF SECTION 29, T2N, R97W,**  
**6th P.M., RIO BLANCO COUNTY, COLORADO**

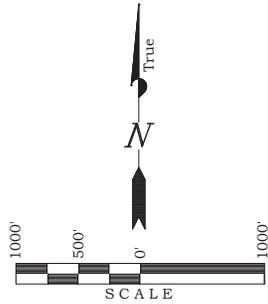


**SURVEYOR'S CERTIFICATE**

I, BROCK J. SLAUGH, DO HEREBY CERTIFY THAT I AM A PROFESSIONAL LAND SURVEYOR AND THAT I HOLD CERTIFICATE #38443 AS PRESCRIBED BY THE LAWS OF THE STATE OF COLORADO. I FURTHER CERTIFY THAT THIS PLAT AND ITS COMPUTATIONS AND FIELD SURVEYS NECESSARY FOR THE DATA COMPILED HEREON WERE MADE BY ME OR UNDER MY SUPERVISION AND THE SAME ARE TRUE AND CORRECT TO THE BEST OF MY KNOWLEDGE AND BELIEF; THAT THE SURVEY WAS PERFORMED IN ACCORDANCE WITH APPLICABLE STANDARDS OF PRACTICE AND I DO NOT MAKE A GUARANTY OR WARRANTY, EITHER EXPRESSED OR IMPLIED, THIS CERTIFICATE DOES NOT REPRESENT A LAND SURVEY PLAT OR IMPROVEMENT SURVEY PLAT AS DEFINED BY C.R.S. § 38-5-102 AND CANNOT BE RELIED UPON TO DETERMINE OWNERSHIP.

*Brock J. Slough*  
 BROCK J. SLAUGH  
 38443  
 PROFESSIONAL LAND SURVEYOR  
 COLORADO

<b>TIMBERLINE</b>		
ENGINEERING & LAND SURVEYING, INC. 209 NORTH 300 WEST - VERNAL, UTAH 84078		
DATE SURVEYED: 7-11-23	SURVEYED BY: C.S.	SHEET
DATE DRAWN: 8-29-23	DRAWN BY: S.A.	<b>1A</b>
SCALE: 1" = 1000'	Date Last Revised: 9-27-23 S.A.	OF 39

# T2N, R97W, 6th P.M.

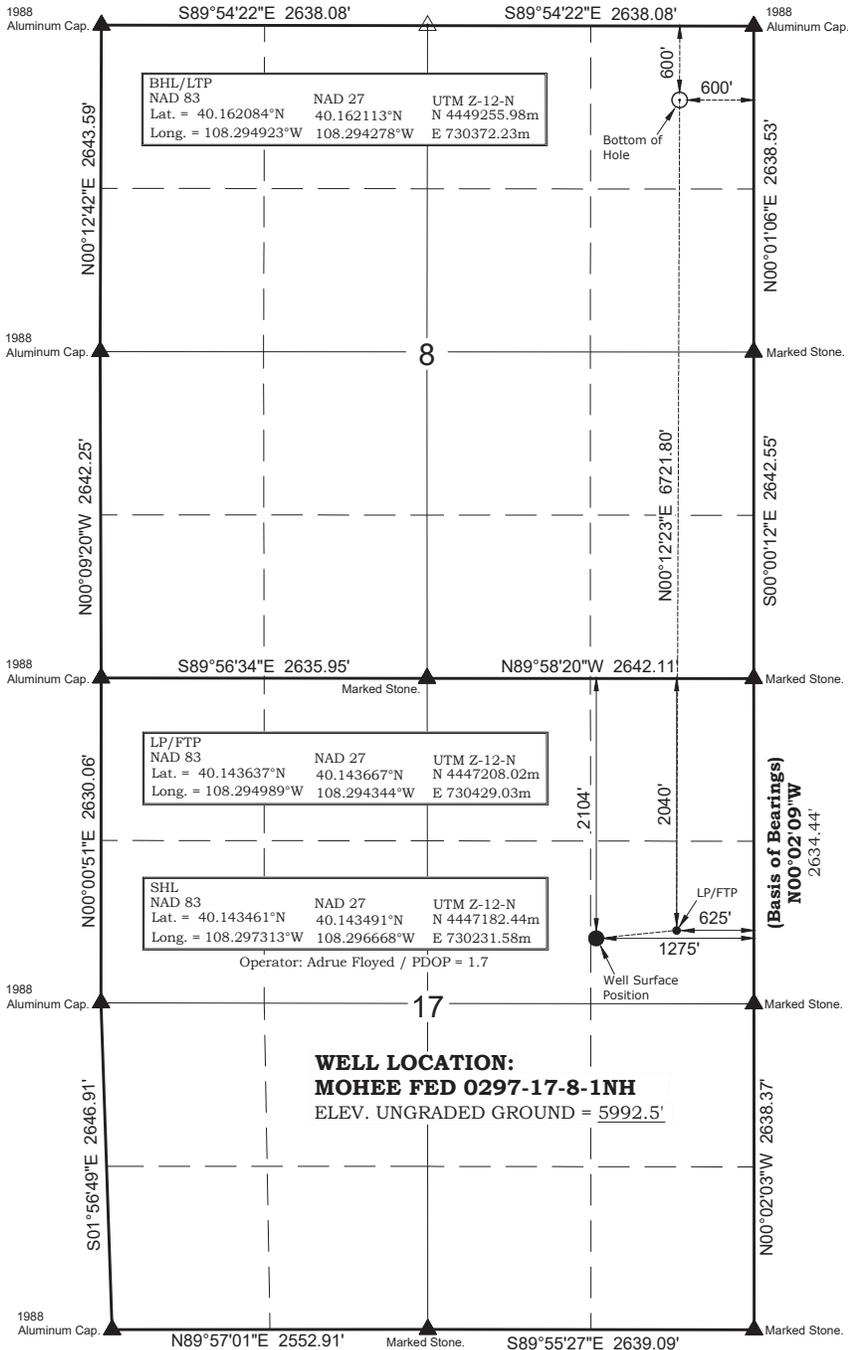

BHL/LTP  
 NAD 83                      NAD 27                      UTM Z-12-N  
 Lat. = 40.162084°N      40.162113°N      N 4449255.98m  
 Long. = 108.294923°W    108.294278°W    E 730372.23m

LP/FTP  
 NAD 83                      NAD 27                      UTM Z-12-N  
 Lat. = 40.143637°N      40.143667°N      N 4447208.02m  
 Long. = 108.294989°W    108.294344°W    E 730429.03m

SHL  
 NAD 83                      NAD 27                      UTM Z-12-N  
 Lat. = 40.143461°N      40.143491°N      N 4447182.44m  
 Long. = 108.297313°W    108.296668°W    E 730231.58m

Operator: Adrue Floyed / PDOP = 1.7


**WELL LOCATION:**  
**MOHEE FED 0297-17-8-1NH**  
 ELEV. UNGRADED GROUND = 5992.5'

**NOTES:**

- ▲ = Section Corners Located
- △ = Section Corners Located Not Monumented
- 1. Well footages are measured at right angles to the Section Lines.
- 2. Bearings and distances shown on this plat are based upon a local Cartesian Grid which is oriented to Geodetic North at the SE Corner of Section 36, T2N, R97W, 6th P.M. The grid having a mean project height of 6,250'. Lineal units used are U.S. Survey Foot. Trimble G.P.S. equipment was used in performance of this survey.
- 3. Latitude and Longitude are NAD 83 (2011) Epoch 2010. Elevations are NAVD 88. Which are derived from an NGS OPUS Report.
- 4. LP/FTP Bears N84°24'46"E 653.24' from the Surface Position.

**ANSCHUTZ**  
**EXPLORATION CORPORATION**  
 555 17th Street, Suite 2400 - Denver, Colorado 80202

**WELL PLAT**  
**MOHEE FED 0297-17-8-1NH**  
**600' FNL & 600' FEL (Bottom Hole)**  
**NE ¼ NE ¼ OF SECTION 8, T2N, R97W,**  
**6th P.M., RIO BLANCO COUNTY, COLORADO**

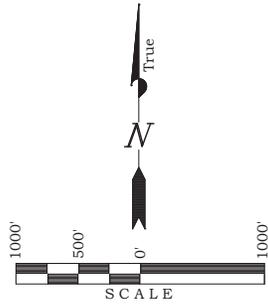


**SURVEYOR'S CERTIFICATE**

I, BROCK J. SLAUGH, DO HEREBY CERTIFY THAT I AM A PROFESSIONAL LAND SURVEYOR AND THAT I HOLD CERTIFICATE #38443 AS PRESCRIBED BY THE LAWS OF THE STATE OF COLORADO. I FURTHER CERTIFY THAT THIS PLAT AND ITS COMPUTATIONS AND FIELD SURVEYS NECESSARY FOR THE DATA COMPILED HEREON WERE MADE BY ME OR UNDER MY SUPERVISION AND THE SAME ARE TRUE AND CORRECT TO THE BEST OF MY KNOWLEDGE AND BELIEF; THAT THE SURVEY WAS PERFORMED IN ACCORDANCE WITH APPLICABLE STANDARDS OF PRACTICE AND I AM NOT PROVIDING A GUARANTY OR WARRANTY, EITHER EXPRESSED OR IMPLIED. THIS CERTIFICATE DOES NOT REPRESENT A LAND SURVEY PLAT OR IMPROVEMENT SURVEY PLAT AS DEFINED BY C.R.S. § 38-5-102 AND CANNOT BE RELIED UPON TO DETERMINE OWNERSHIP.

*Brock J. Slough*  
 38443  
 PROFESSIONAL LAND SURVEYOR  
 STATE OF COLORADO

<b>TIMBERLINE</b>		
ENGINEERING & LAND SURVEYING, INC. 209 NORTH 300 WEST - VERNAL, UTAH 84078		
DATE SURVEYED: 7-11-23	SURVEYED BY: C.S.	SHEET
DATE DRAWN: 8-29-23	DRAWN BY: S.A.	<b>2</b>
SCALE: 1" = 1000'	Date Last Revised: 9-27-23	OF 39

**T2N, R97W,  
6th P.M.**

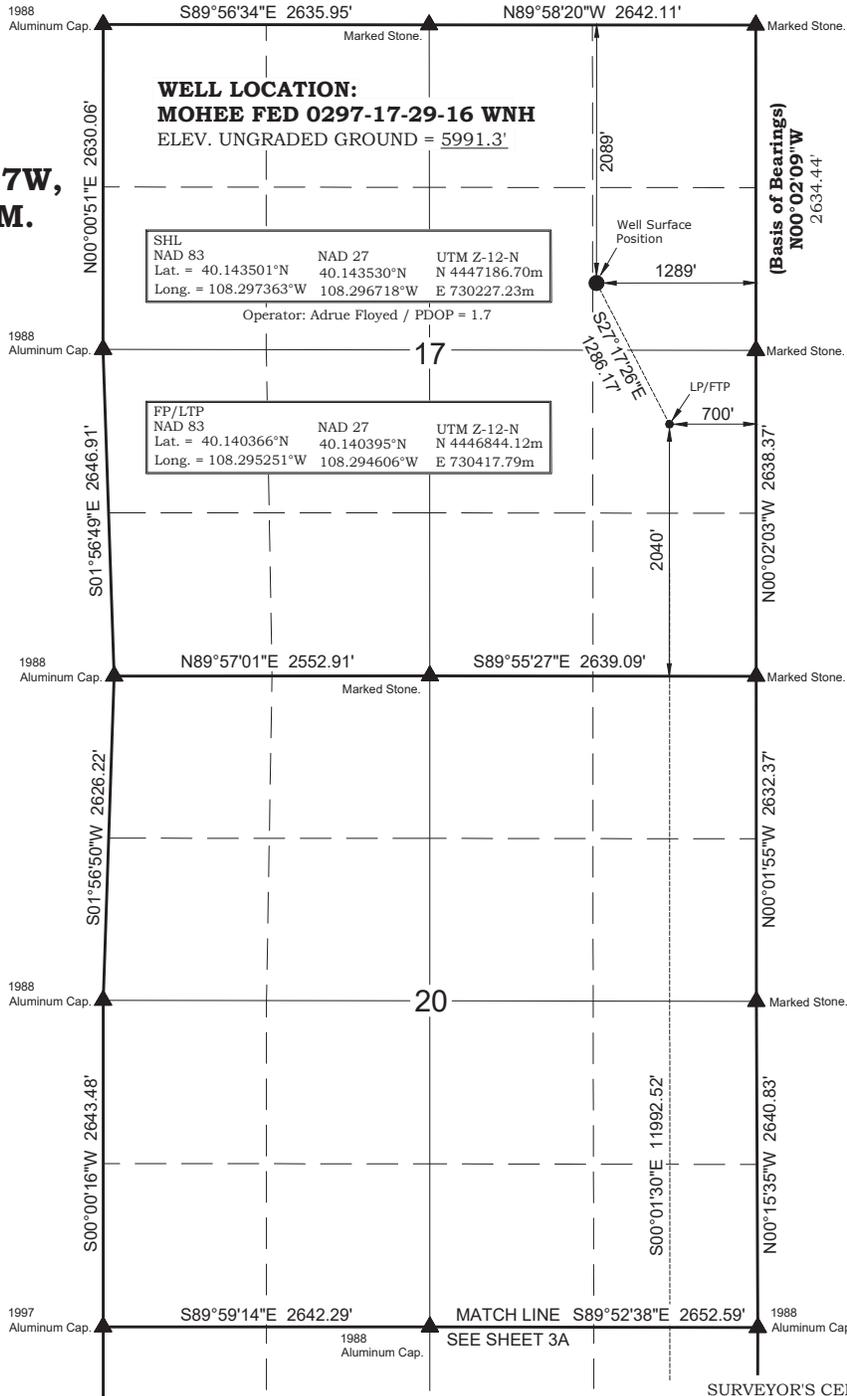

**WELL LOCATION:  
MOHEE FED 0297-17-29-16 WNH**  
ELEV. UNGRADED GROUND = 5991.3'

SHL  
NAD 83                      NAD 27                      UTM Z-12-N  
Lat. = 40.143501°N      40.143530°N      N 4447186.70m  
Long. = 108.297363°W    108.296718°W    E 730227.23m

Operator: Adrue Floyd / PDOP = 1.7

FP/LTP  
NAD 83                      NAD 27                      UTM Z-12-N  
Lat. = 40.140366°N      40.140395°N      N 4446844.12m  
Long. = 108.295251°W    108.294606°W    E 730417.79m


**NOTES:**

- ▲ = Section Corners Located
- △ = Section Corners Located Not Monumented
- 1. Well footages are measured at right angles to the Section Lines.
- 2. Bearings and distances shown on this plat are based upon a local Cartesian Grid which is oriented to Geodetic North at the SE Corner of Section 36, T2N, R97W, 6th P.M. The grid having a mean project height of 6,250'. Lineal units used are U.S. Survey Foot. Trimble G.P.S. equipment was used in performance of this survey.
- 3. Latitude and Longitude are NAD 83 (2011) Epoch 2010. Elevations are NAVD 88. Which are derived from an NGS OPUS Report.

**ANSCHUTZ  
EXPLORATION CORPORATION**  
555 17th Street, Suite 2400 - Denver, Colorado 80202


**WELL PLAT**

**MOHEE FED 0297-17-29-16 WNH**  
**600' FSL & 700' FEL (Bottom Hole)**  
**SE ¼ SE ¼ OF SECTION 29, T2N, R97W,**  
**6th P.M., RIO BLANCO COUNTY, COLORADO**

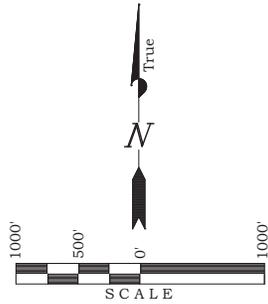


**SURVEYOR'S CERTIFICATE**

I, BROCK J. SLAUGH, DO HEREBY CERTIFY THAT I AM A PROFESSIONAL LAND SURVEYOR AND THAT I HOLD CERTIFICATE #38443 AS PRESCRIBED BY THE LAWS OF THE STATE OF COLORADO. I FURTHER CERTIFY THAT THIS PLAT AND ITS COMPUTATIONS AND FIELD SURVEYS NECESSARY FOR THE DATA COMPILED HEREON WERE MADE BY ME OR UNDER MY SUPERVISION AND THE SAME ARE TRUE AND CORRECT TO THE BEST OF MY KNOWLEDGE AND BELIEF; 

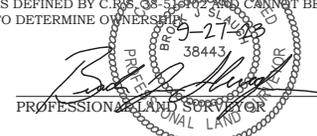

<b>TIMBERLINE</b>		
ENGINEERING & LAND SURVEYING, INC. 209 NORTH 300 WEST - VERNAL, UTAH 84078		
DATE SURVEYED: 7-11-23	SURVEYED BY: C.S.	SHEET
DATE DRAWN: 8-29-23	DRAWN BY: S.A.	<b>3</b>
SCALE: 1" = 1000'	Date Last Revised: 9-27-23 S.A.	OF 39

**T2N, R97W,  
6th P.M.**

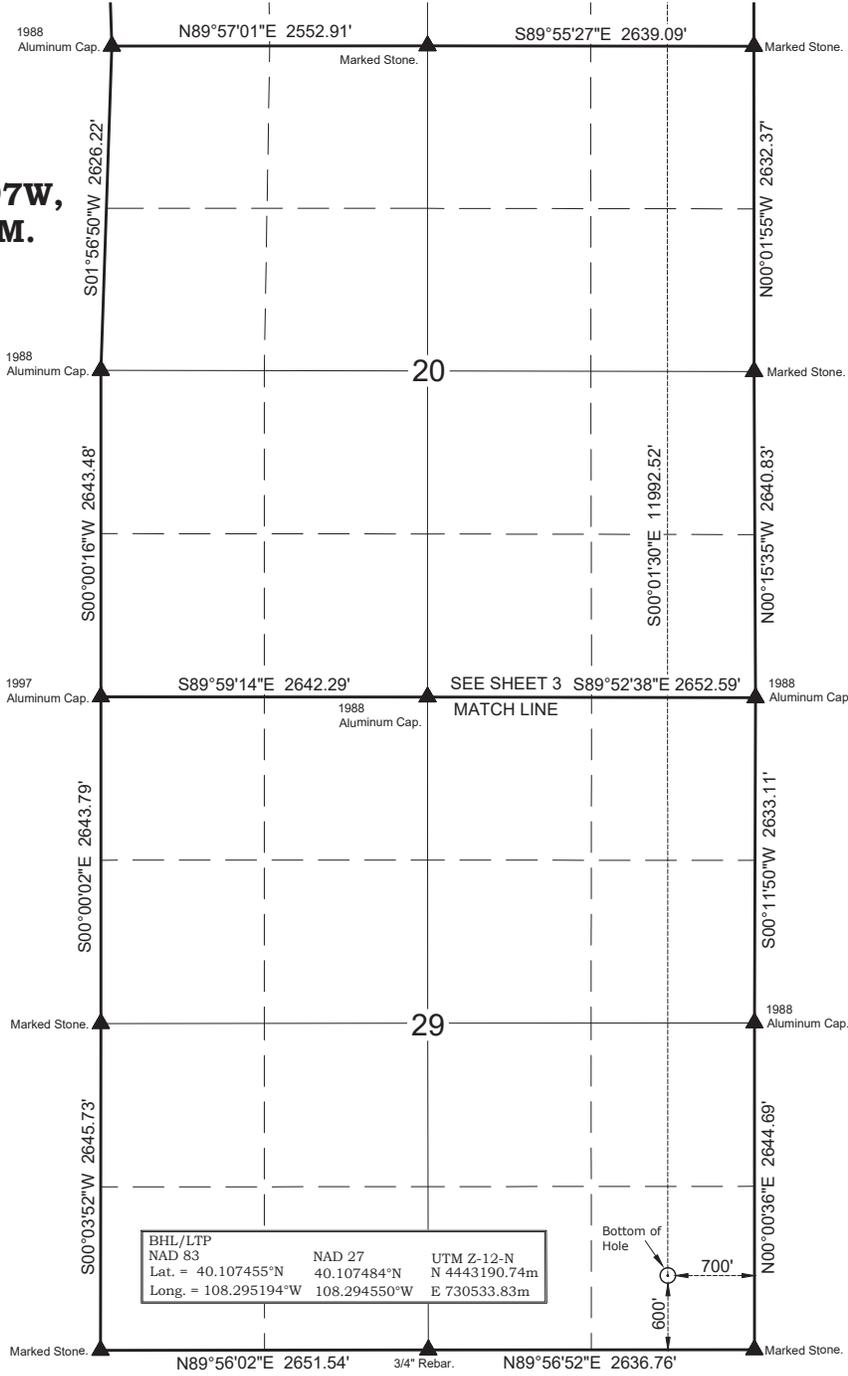


**NOTES:**

- ▲ = Section Corners Located
- △ = Section Corners Located Not Monumented
- 1. Well footages are measured at right angles to the Section Lines.
- 2. Bearings and distances shown on this plat are based upon a local Cartesian Grid which is oriented to Geodetic North at the SE Corner of Section 36, T2N, R97W, 6th P.M. The grid having a mean project height of 6,250'. Lineal units used are U.S. Survey Foot. Trimble G.P.S. equipment was used in performance of this survey.
- 3. Latitude and Longitude are NAD 83 (2011) Epoch 2010. Elevations are NAVD 88. Which are derived from an NGS OPUS Report.

**ANSCHUTZ  
EXPLORATION CORPORATION**  
555 17th Street, Suite 2400 - Denver, Colorado 80202

**WELL PLAT**

**MOHEE FED 0297-17-29-16 WNH  
600' FSL & 700' FEL (Bottom Hole)  
SE ¼ SE ¼ OF SECTION 29, T2N, R97W,  
6th P.M., RIO BLANCO COUNTY, COLORADO**

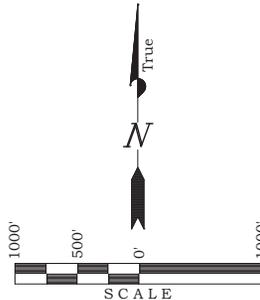

**SURVEYOR'S CERTIFICATE**


I, BROCK J. SLAUGH, DO HEREBY CERTIFY THAT I AM A PROFESSIONAL LAND SURVEYOR AND THAT I HOLD CERTIFICATE #38443 AS PRESCRIBED BY THE LAWS OF THE STATE OF COLORADO. I FURTHER CERTIFY THAT THIS PLAT AND ITS COMPUTATIONS AND FIELD SURVEYS NECESSARY FOR THE DATA COMPILED HEREON WERE MADE BY ME OR UNDER MY SUPERVISION AND THE SAME ARE TRUE AND CORRECT TO THE BEST OF MY KNOWLEDGE AND BELIEF; 

*Brock J. Slough*  
38443  
PROFESSIONAL LAND SURVEYOR  
STATE OF COLORADO

**TIMBERLINE**  
ENGINEERING & LAND SURVEYING, INC.  
209 NORTH 300 WEST - VERNAL, UTAH 84078

DATE SURVEYED: 7-11-23	SURVEYED BY: C.S.	SHEET
DATE DRAWN: 8-29-23	DRAWN BY: S.A.	<b>3A</b>
SCALE: 1" = 1000'	Date Last Revised: 9-27-23 S.A.	OF 39

**T2N, R97W,  
6th P.M.**

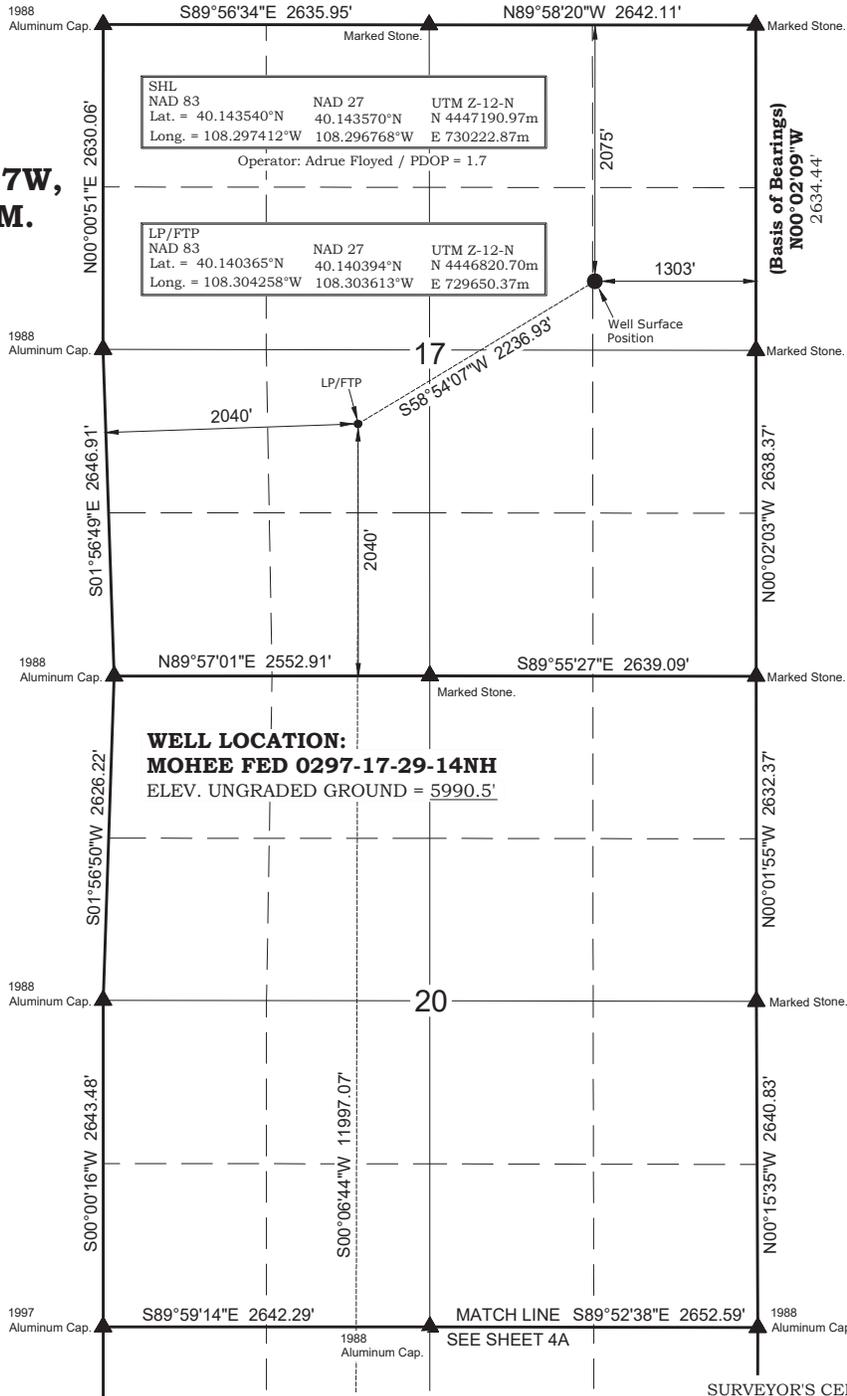

SHL  
NAD 83                      NAD 27                      UTM Z-12-N  
Lat. = 40.143540°N      40.143570°N      N 4447190.97m  
Long. = 108.297412°W    108.296768°W    E 730222.87m  
Operator: Adrue Floyed / PDOP = 1.7

LP/FTP  
NAD 83                      NAD 27                      UTM Z-12-N  
Lat. = 40.140365°N      40.140394°N      N 4446820.70m  
Long. = 108.304258°W    108.303613°W    E 729650.37m


**WELL LOCATION:  
MOHEE FED 0297-17-29-14NH**  
ELEV. UNGRADED GROUND = 5990.5'

**NOTES:**

- ▲ = Section Corners Located
- △ = Section Corners Located Not Monumented
- 1. Well footages are measured at right angles to the Section Lines.
- 2. Bearings and distances shown on this plat are based upon a local Cartesian Grid which is oriented to Geodetic North at the SE Corner of Section 36, T2N, R97W, 6th P.M. The grid having a mean project height of 6,250'. Lineal units used are U.S. Survey Foot. Trimble G.P.S. equipment was used in performance of this survey.
- 3. Latitude and Longitude are NAD 83 (2011) Epoch 2010. Elevations are NAVD 88. Which are derived from an NGS OPUS Report.


**ANSCHUTZ  
EXPLORATION CORPORATION**  
555 17th Street, Suite 2400 - Denver, Colorado 80202

**WELL PLAT**  
  
**MOHEE FED 0297-17-29-14NH**  
**600' FSL & 2040' FWL (Bottom Hole)**  
**SE ¼ SW ¼ OF SECTION 29, T2N, R97W,**  
**6th P.M., RIO BLANCO COUNTY, COLORADO**

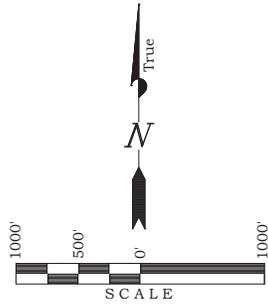


**SURVEYOR'S CERTIFICATE**

I, BROCK J. SLAUGH, DO HEREBY CERTIFY THAT I AM A PROFESSIONAL LAND SURVEYOR AND THAT I HOLD CERTIFICATE #38443 AS PRESCRIBED BY THE LAWS OF THE STATE OF COLORADO. I FURTHER CERTIFY THAT THIS PLAT AND ITS COMPUTATIONS AND FIELD SURVEYS NECESSARY FOR THE DATA COMPILED HEREON WERE MADE BY ME OR UNDER MY SUPERVISION AND THE SAME ARE TRUE AND CORRECT TO THE BEST OF MY KNOWLEDGE AND BELIEF; 

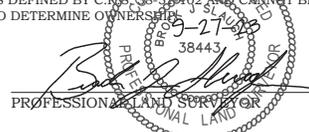

<b>TIMBERLINE</b>		
ENGINEERING & LAND SURVEYING, INC. 209 NORTH 300 WEST - VERNAL, UTAH 84078		
DATE SURVEYED: 7-11-23	SURVEYED BY: C.S.	SHEET <b>4</b>
DATE DRAWN: 8-29-23	DRAWN BY: S.A.	
SCALE: 1" = 1000'	Date Last Revised: 9-27-23 S.A.	OF 39

**T2N, R97W,  
6th P.M.**

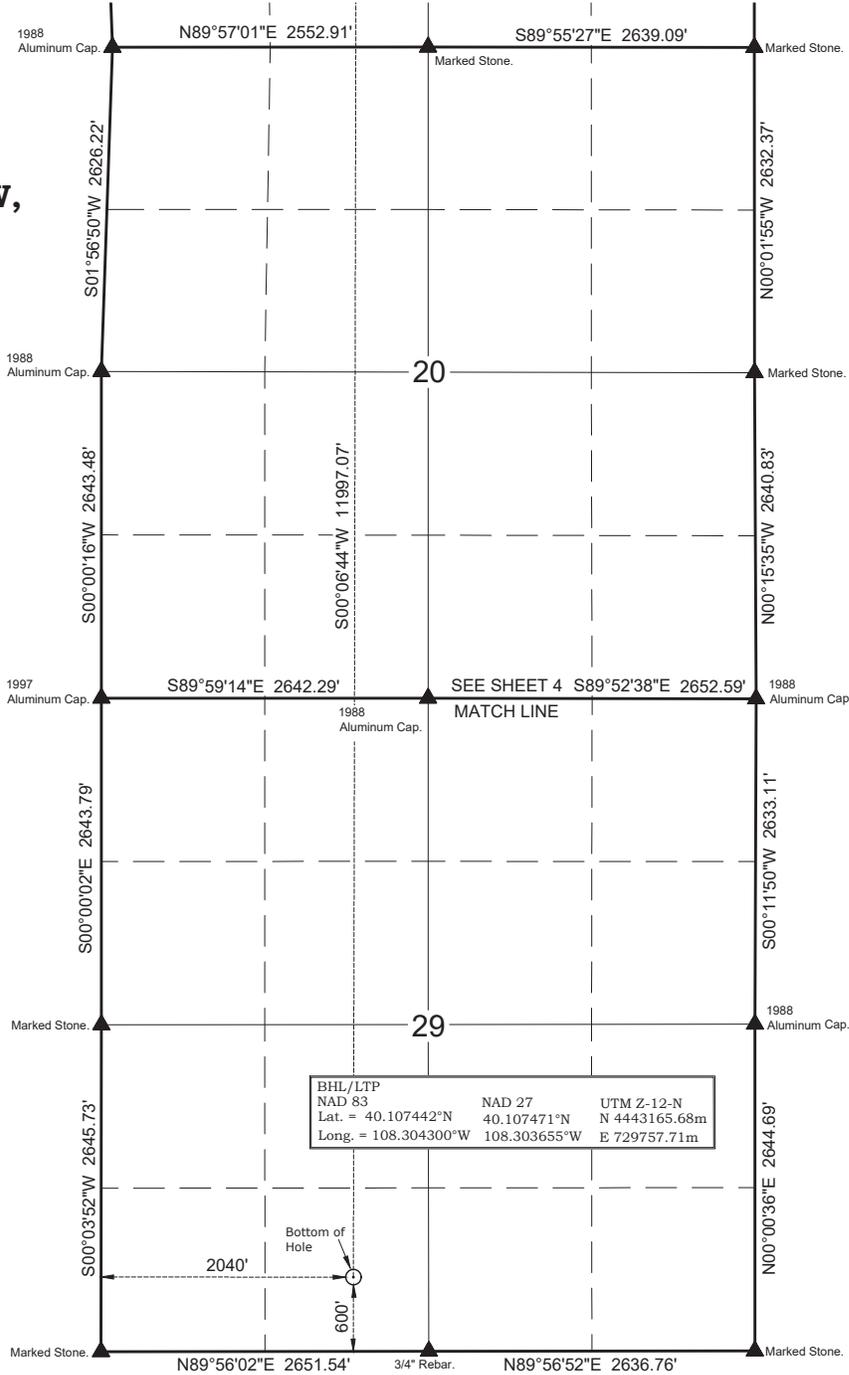

BHL/LTP  
 NAD 83                      NAD 27                      UTM Z-12-N  
 Lat. = 40.107442°N      40.107471°N      N 4443165.68m  
 Long. = 108.304300°W    108.303655°W      E 729757.71m


**NOTES:**

- ▲ = Section Corners Located
- △ = Section Corners Located Not Monumented
- 1. Well footages are measured at right angles to the Section Lines.
- 2. Bearings and distances shown on this plat are based upon a local Cartesian Grid which is oriented to Geodetic North at the SE Corner of Section 36, T2N, R97W, 6th P.M. The grid having a mean project height of 6,250'. Lineal units used are U.S. Survey Foot. Trimble G.P.S. equipment was used in performance of this survey.
- 3. Latitude and Longitude are NAD 83 (2011) Epoch 2010. Elevations are NAVD 88. Which are derived from an NGS OPUS Report.

**ANSCHUTZ  
EXPLORATION CORPORATION**  
 555 17th Street, Suite 2400 - Denver, Colorado 80202

**WELL PLAT**

**MOHEE FED 0297-17-29-14NH  
600' FSL & 2040' FWL (Bottom Hole)  
SE ¼ SW ¼ OF SECTION 29, T2N, R97W,  
6th P.M., RIO BLANCO COUNTY, COLORADO**

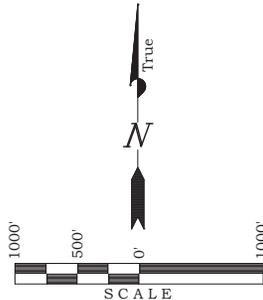


**SURVEYOR'S CERTIFICATE**

I, BROCK J. SLAUGH, DO HEREBY CERTIFY THAT I AM A PROFESSIONAL LAND SURVEYOR AND THAT I HOLD CERTIFICATE #38443 AS PRESCRIBED BY THE LAWS OF THE STATE OF COLORADO. I FURTHER CERTIFY THAT THIS PLAT AND ITS COMPUTATIONS AND FIELD SURVEYS NECESSARY FOR THE DATA COMPILED HEREON WERE MADE BY ME OR UNDER MY SUPERVISION AND THE SAME ARE TRUE AND CORRECT TO THE BEST OF MY KNOWLEDGE AND BELIEF; THAT THE SURVEY WAS PERFORMED IN ACCORDANCE WITH APPLICABLE STANDARDS OF PRACTICE AND I AM PROVIDING A GUARANTY OR WARRANTY, EITHER EXPRESSED OR IMPLIED, THIS CERTIFICATE DOES NOT REPRESENT A LAND SURVEY PLAT OR IMPROVEMENT SURVEY PLAT AS DEFINED BY C.R.S. § 38-5-102 AND CANNOT BE RELIED UPON TO DETERMINE OWNERSHIP.

*Brock J. Slaugh*  
 38443  
 PROFESSIONAL LAND SURVEYOR  
 STATE OF COLORADO

<b>TIMBERLINE</b>		
ENGINEERING & LAND SURVEYING, INC. 209 NORTH 300 WEST - VERNAL, UTAH 84078		
DATE SURVEYED: 7-11-23	SURVEYED BY: C.S.	SHEET
DATE DRAWN: 8-29-23	DRAWN BY: S.A.	<b>4A</b>
SCALE: 1" = 1000'	Date Last Revised: 9-27-23 S.A.	OF 39

**T2N, R97W,  
6th P.M.**

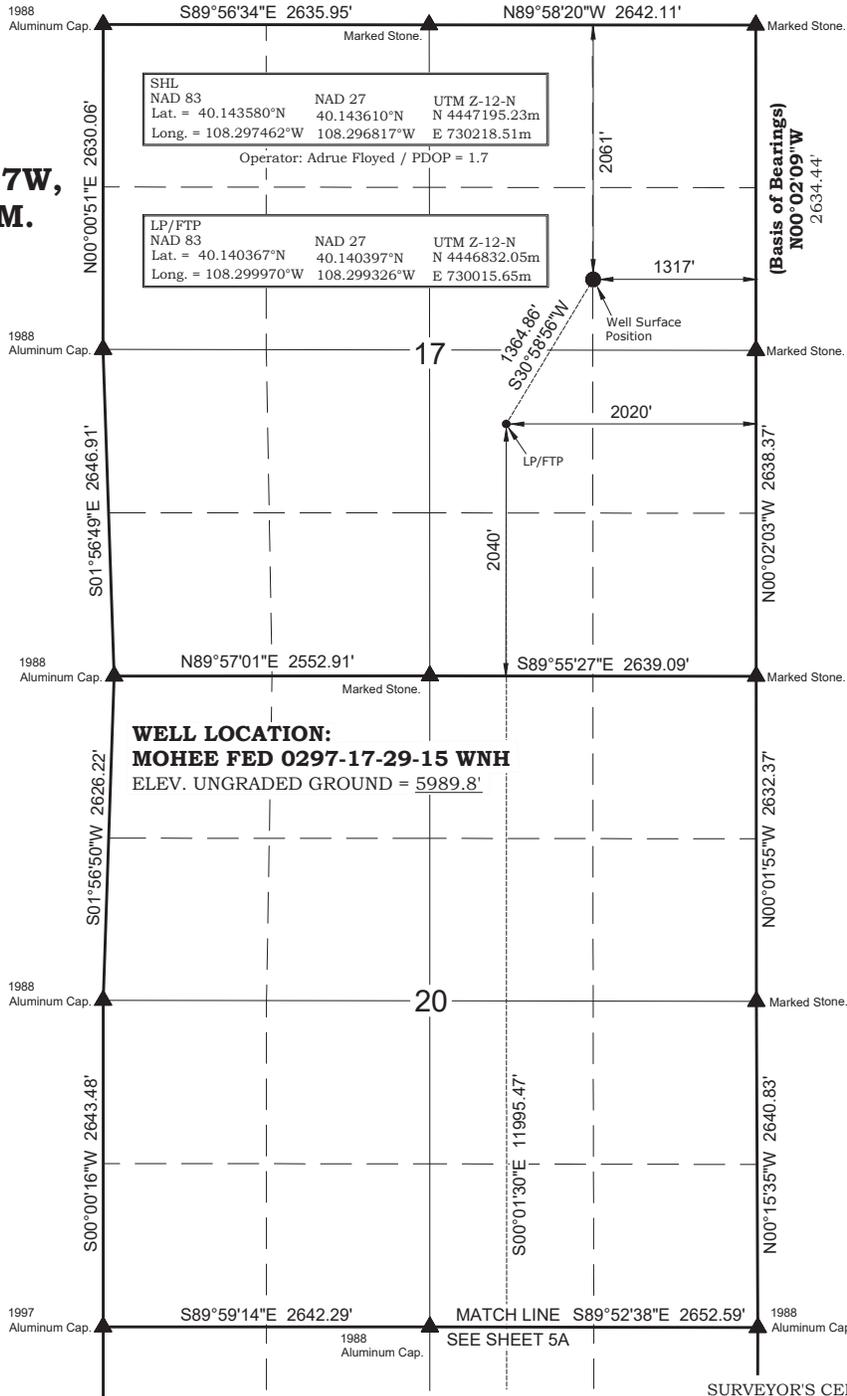

**WELL LOCATION:  
MOHEE FED 0297-17-29-15 WNH  
ELEV. UNGRADED GROUND = 5989.8'**


**NOTES:**

- ▲ = Section Corners Located
- △ = Section Corners Located Not Monumented
- 1. Well footages are measured at right angles to the Section Lines.
- 2. Bearings and distances shown on this plat are based upon a local Cartesian Grid which is oriented to Geodetic North at the SE Corner of Section 36, T2N, R97W, 6th P.M. The grid having a mean project height of 6,250'. Lineal units used are U.S. Survey Foot. Trimble G.P.S. equipment was used in performance of this survey.
- 3. Latitude and Longitude are NAD 83 (2011) Epoch 2010. Elevations are NAVD 88. Which are derived from an NGS OPUS Report.

**ANSCHUTZ  
EXPLORATION CORPORATION**  
555 17th Street, Suite 2400 - Denver, Colorado 80202


**WELL PLAT**

**MOHEE FED 0297-17-29-15 WNH  
600' FSL & 2020' FEL (Bottom Hole)  
SW ¼ SE ¼ OF SECTION 29, T2N, R97W,  
6th P.M., RIO BLANCO COUNTY, COLORADO**

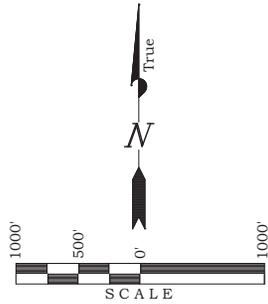


**SURVEYOR'S CERTIFICATE**

I, BROCK J. SLAUGH, DO HEREBY CERTIFY THAT I AM A PROFESSIONAL LAND SURVEYOR AND THAT I HOLD CERTIFICATE #38443 AS PRESCRIBED BY THE LAWS OF THE STATE OF COLORADO. I FURTHER CERTIFY THAT THIS PLAT AND ITS COMPUTATIONS AND FIELD SURVEYS NECESSARY FOR THE DATA COMPILED HEREON WERE MADE BY ME OR UNDER MY SUPERVISION AND THE SAME ARE TRUE AND CORRECT TO THE BEST OF MY KNOWLEDGE AND BELIEF; THAT THE SURVEY WAS PERFORMED IN ACCORDANCE WITH APPLICABLE STANDARDS OF PRACTICE AND I DO NOT MAKE A GUARANTY OR WARRANTY, EITHER EXPRESSED OR IMPLIED, THIS CERTIFICATE DOES NOT REPRESENT A LAND SURVEY PLAT OR IMPROVEMENT SURVEY PLAT AS DEFINED BY C.R.S. § 38-5-102 AND CANNOT BE RELIED UPON TO DETERMINE OWNERSHIP.

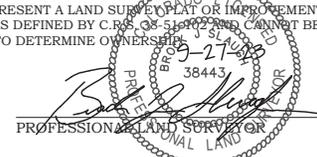

<b>TIMBERLINE</b>		
ENGINEERING & LAND SURVEYING, INC. 209 NORTH 300 WEST - VERNAL, UTAH 84078		
DATE SURVEYED: 7-11-23	SURVEYED BY: C.S.	SHEET
DATE DRAWN: 8-29-23	DRAWN BY: S.A.	<b>5</b>
SCALE: 1" = 1000'	Date Last Revised: 9-27-23 S.A.	OF 39

**T2N, R97W,  
6th P.M.**

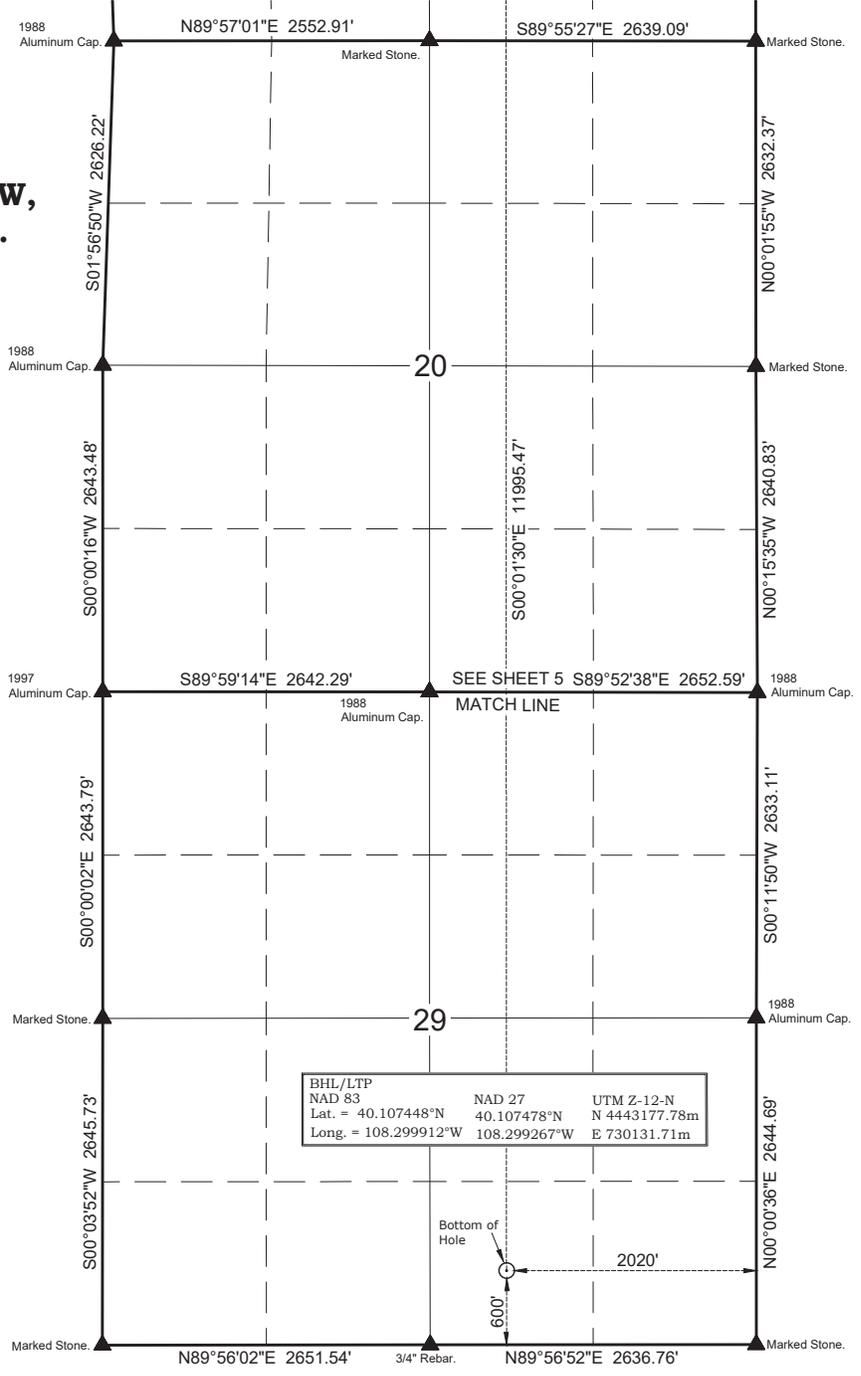

BHL/LTP		
NAD 83	NAD 27	UTM Z-12-N
Lat. = 40.107448°N	40.107478°N	N 4443177.78m
Long. = 108.299912°W	108.299267°W	E 730131.71m


**NOTES:**

- ▲ = Section Corners Located
- △ = Section Corners Located Not Monumented
- 1. Well footages are measured at right angles to the Section Lines.
- 2. Bearings and distances shown on this plat are based upon a local Cartesian Grid which is oriented to Geodetic North at the SE Corner of Section 36, T2N, R97W, 6th P.M. The grid having a mean project height of 6,250'. Lineal units used are U.S. Survey Foot. Trimble G.P.S. equipment was used in performance of this survey.
- 3. Latitude and Longitude are NAD 83 (2011) Epoch 2010. Elevations are NAVD 88. Which are derived from an NGS OPUS Report.

**ANSCHUTZ  
EXPLORATION CORPORATION**  
555 17th Street, Suite 2400 - Denver, Colorado 80202


**WELL PLAT**

**MOHEE FED 0297-17-29-15 WNH  
600' FSL & 2020' FEL (Bottom Hole)  
SW ¼ SE ¼ OF SECTION 29, T2N, R97W,  
6th P.M., RIO BLANCO COUNTY, COLORADO**

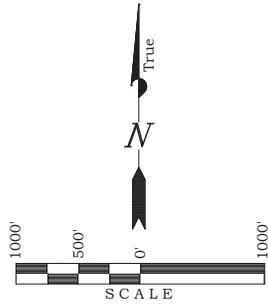


**SURVEYOR'S CERTIFICATE**

I, BROCK J. SLAUGH, DO HEREBY CERTIFY THAT I AM A PROFESSIONAL LAND SURVEYOR AND THAT I HOLD CERTIFICATE #38443 AS PRESCRIBED BY THE LAWS OF THE STATE OF COLORADO. I FURTHER CERTIFY THAT THIS PLAT AND ITS COMPUTATIONS AND FIELD SURVEYS NECESSARY FOR THE DATA COMPILED HEREON WERE MADE BY ME OR UNDER MY SUPERVISION AND THE SAME ARE TRUE AND CORRECT TO THE BEST OF MY KNOWLEDGE AND BELIEF; THAT THE SURVEY WAS PERFORMED IN ACCORDANCE WITH APPLICABLE STANDARDS OF PRACTICE AND I AM NOT PROVIDING A GUARANTY OR WARRANTY, EITHER EXPRESSED OR IMPLIED, THIS CERTIFICATE DOES NOT REPRESENT A LAND SURVEY PLAT OR IMPROVEMENT SURVEY PLAT AS DEFINED BY C.R.S. § 38-5-102 AND CANNOT BE RELIED UPON TO DETERMINE OWNERSHIP.

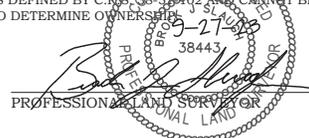

<b>TIMBERLINE</b>		
ENGINEERING & LAND SURVEYING, INC. 209 NORTH 300 WEST - VERNAL, UTAH 84078		
DATE SURVEYED: 7-11-23	SURVEYED BY: C.S.	SHEET
DATE DRAWN: 8-29-23	DRAWN BY: S.A.	<b>5A</b>
SCALE: 1" = 1000'	Date Last Revised: 9-27-13 S.A.	OF 39

# T2N, R97W, 6th P.M.

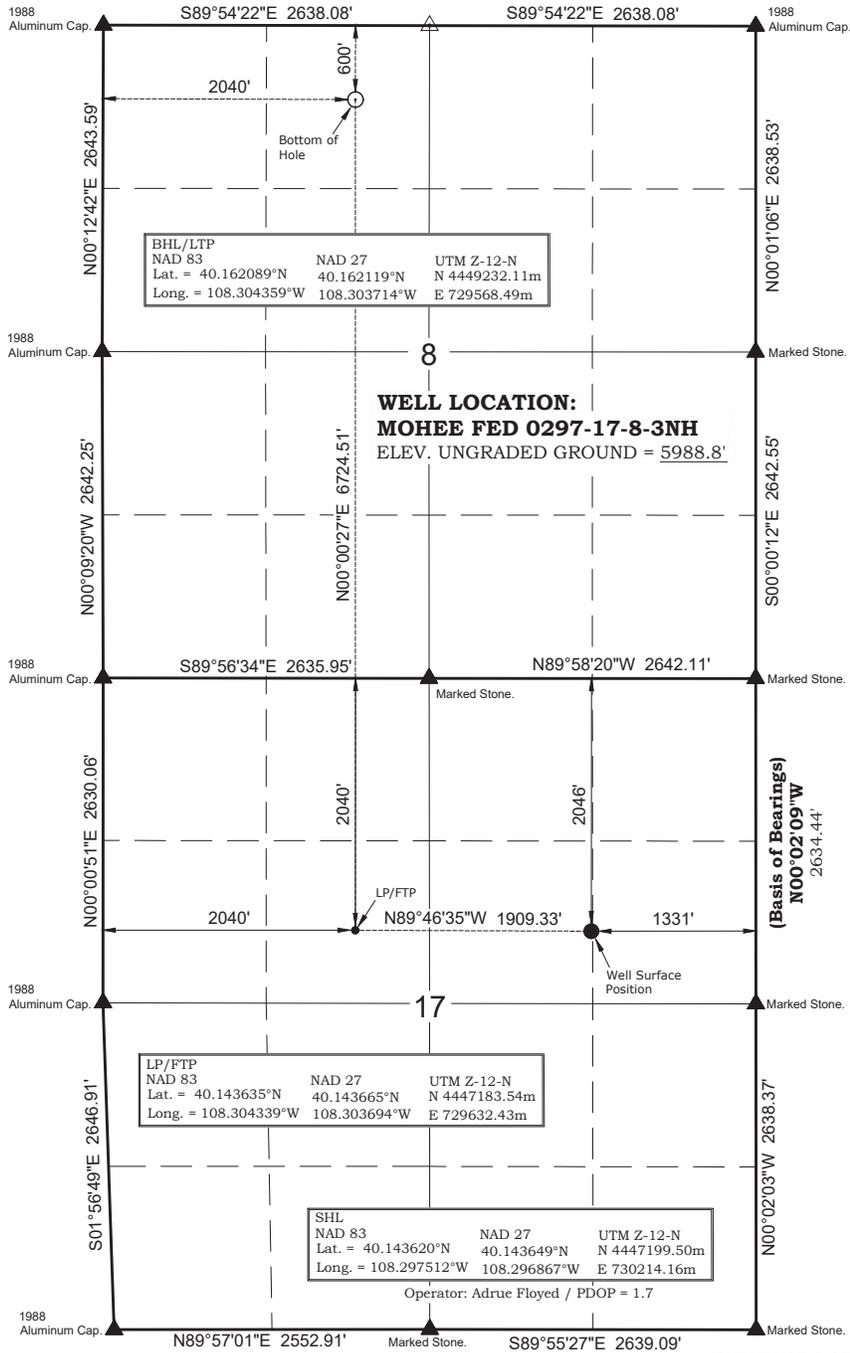

BHL/LTP		
NAD 83	NAD 27	UTM Z-12-N
Lat. = 40.162089°N	40.162119°N	N 4449232.11m
Long. = 108.304359°W	108.303714°W	E 729568.49m

LP/FTP		
NAD 83	NAD 27	UTM Z-12-N
Lat. = 40.143635°N	40.143665°N	N 4447183.54m
Long. = 108.304339°W	108.303694°W	E 729632.43m

SHL		
NAD 83	NAD 27	UTM Z-12-N
Lat. = 40.143620°N	40.143649°N	N 4447199.50m
Long. = 108.297512°W	108.296867°W	E 730214.16m

Operator: Adrue Floyd / PDOP = 1.7

**NOTES:**

- ▲ = Section Corners Located
- △ = Section Corners Located Not Monumented
- 1. Well footages are measured at right angles to the Section Lines.
- 2. Bearings and distances shown on this plat are based upon a local Cartesian Grid which is oriented to Geodetic North at the SE Corner of Section 36, T2N, R97W, 6th P.M. The grid having a mean project height of 6,250'. Lineal units used are U.S. Survey Foot. Trimble G.P.S. equipment was used in performance of this survey.
- 3. Latitude and Longitude are NAD 83 (2011) Epoch 2010. Elevations are NAVD 88. Which are derived from an NGS OPUS Report.


**ANSCHUTZ**

**EXPLORATION CORPORATION**

555 17th Street, Suite 2400 - Denver, Colorado 80202

**WELL PLAT**

**MOHEE FED 0297-17-8-3NH**  
**600' FNL & 2040' FWL (Bottom Hole)**  
**NE ¼ NW ¼ OF SECTION 8, T2N, R97W,**  
**6th P.M., RIO BLANCO COUNTY, COLORADO**

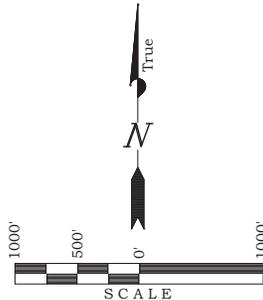

**SURVEYOR'S CERTIFICATE**

I, BROCK J. SLAUGH, DO HEREBY CERTIFY THAT I AM A PROFESSIONAL LAND SURVEYOR AND THAT I HOLD CERTIFICATE #38443 AS PRESCRIBED BY THE LAWS OF THE STATE OF COLORADO. I FURTHER CERTIFY THAT THIS PLAT AND ITS COMPUTATIONS AND FIELD SURVEYS NECESSARY FOR THE DATA COMPILED HEREON WERE MADE BY ME OR UNDER MY SUPERVISION AND THE SAME ARE TRUE AND CORRECT TO THE BEST OF MY KNOWLEDGE AND BELIEF; THAT THE SURVEY WAS PERFORMED IN ACCORDANCE WITH APPLICABLE STANDARDS OF PRACTICE AND I AM PROVIDING A GUARANTY OR WARRANTY, EITHER EXPRESSED OR IMPLIED, THIS CERTIFICATE DOES NOT REPRESENT A LAND SURVEY PLAT OR IMPROVEMENT SURVEY PLAT AS DEFINED BY C.R.S. § 38-5-102 AND CANNOT BE RELIED UPON TO DETERMINE OWNERSHIP.




**TIMBERLINE**

ENGINEERING & LAND SURVEYING, INC.  
 209 NORTH 300 WEST - VERNAL, UTAH 84078

DATE SURVEYED: 7-11-23	SURVEYED BY: C.S.	SHEET <b>6</b>
DATE DRAWN: 8-29-23	DRAWN BY: S.A.	OF 39
SCALE: 1" = 1000'	Date Last Revised: 9-27-23 S.A.	

**T2N, R97W,  
6th P.M.**

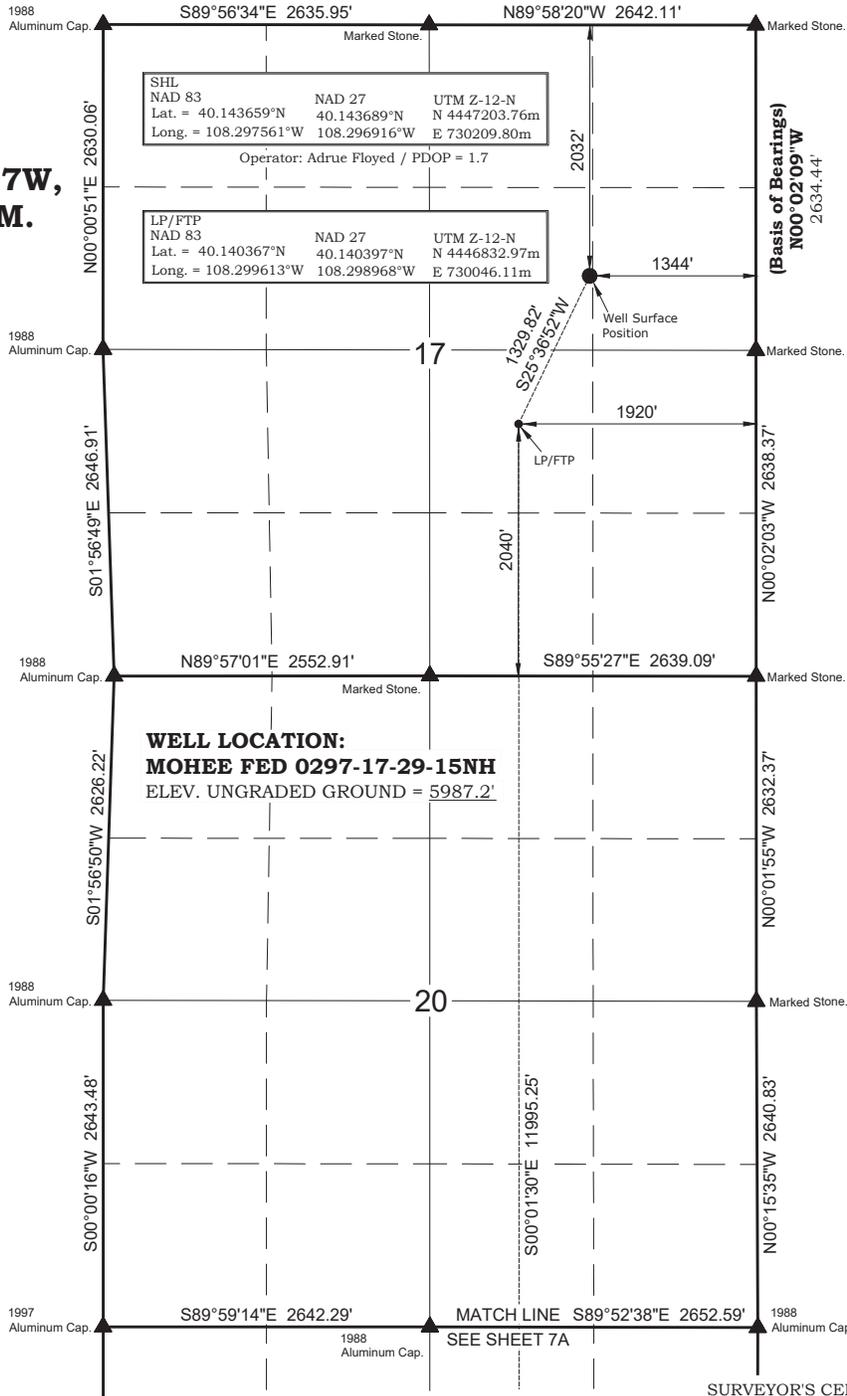


**NOTES:**

- ▲ = Section Corners Located
- △ = Section Corners Located Not Monumented
- 1. Well footages are measured at right angles to the Section Lines.
- 2. Bearings and distances shown on this plat are based upon a local Cartesian Grid which is oriented to Geodetic North at the SE Corner of Section 36, T2N, R97W, 6th P.M. The grid having a mean project height of 6,250'. Lineal units used are U.S. Survey Foot. Trimble G.P.S. equipment was used in performance of this survey.
- 3. Latitude and Longitude are NAD 83 (2011) Epoch 2010. Elevations are NAVD 88. Which are derived from an NGS OPUS Report.

**ANSCHUTZ  
EXPLORATION CORPORATION**  
555 17th Street, Suite 2400 - Denver, Colorado 80202

**WELL PLAT**

**MOHEE FED 0297-17-29-15NH  
600' FSL & 1920' FEL (Bottom Hole)  
SW ¼ SE ¼ OF SECTION 29, T2N, R97W,  
6th P.M., RIO BLANCO COUNTY, COLORADO**

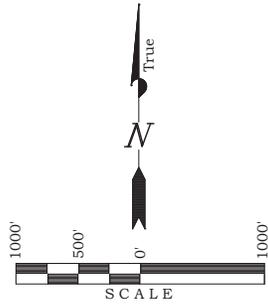


**SURVEYOR'S CERTIFICATE**

I, BROCK J. SLAUGH, DO HEREBY CERTIFY THAT I AM A PROFESSIONAL LAND SURVEYOR AND THAT I HOLD CERTIFICATE #38443 AS PRESCRIBED BY THE LAWS OF THE STATE OF COLORADO. I FURTHER CERTIFY THAT THIS PLAT AND ITS COMPUTATIONS AND FIELD SURVEYS NECESSARY FOR THE DATA COMPILED HEREON WERE MADE BY ME OR UNDER MY SUPERVISION AND THE SAME ARE TRUE AND CORRECT TO THE BEST OF MY KNOWLEDGE AND BELIEF; THAT THE SURVEY WAS PERFORMED IN ACCORDANCE WITH APPLICABLE STANDARDS OF PRACTICE AND I AM PROVIDING A GUARANTY OR WARRANTY, EITHER EXPRESSED OR IMPLIED, THAT THIS CERTIFICATE DOES NOT REPRESENT A LAND SURVEY PLAT OR IMPROVEMENT SURVEY PLAT AS DEFINED BY C.R.S. § 38-5-102 AND CANNOT BE RELIED UPON TO DETERMINE OWNERSHIP.



<b>TIMBERLINE</b>		
ENGINEERING & LAND SURVEYING, INC. 209 NORTH 300 WEST - VERNAL, UTAH 84078		
DATE SURVEYED: 7-11-23	SURVEYED BY: C.S.	SHEET
DATE DRAWN: 8-29-23	DRAWN BY: S.A.	<b>7</b>
SCALE: 1" = 1000'	Date Last Revised: 9-27-23 S.A.	OF 39

**T2N, R97W,  
6th P.M.**

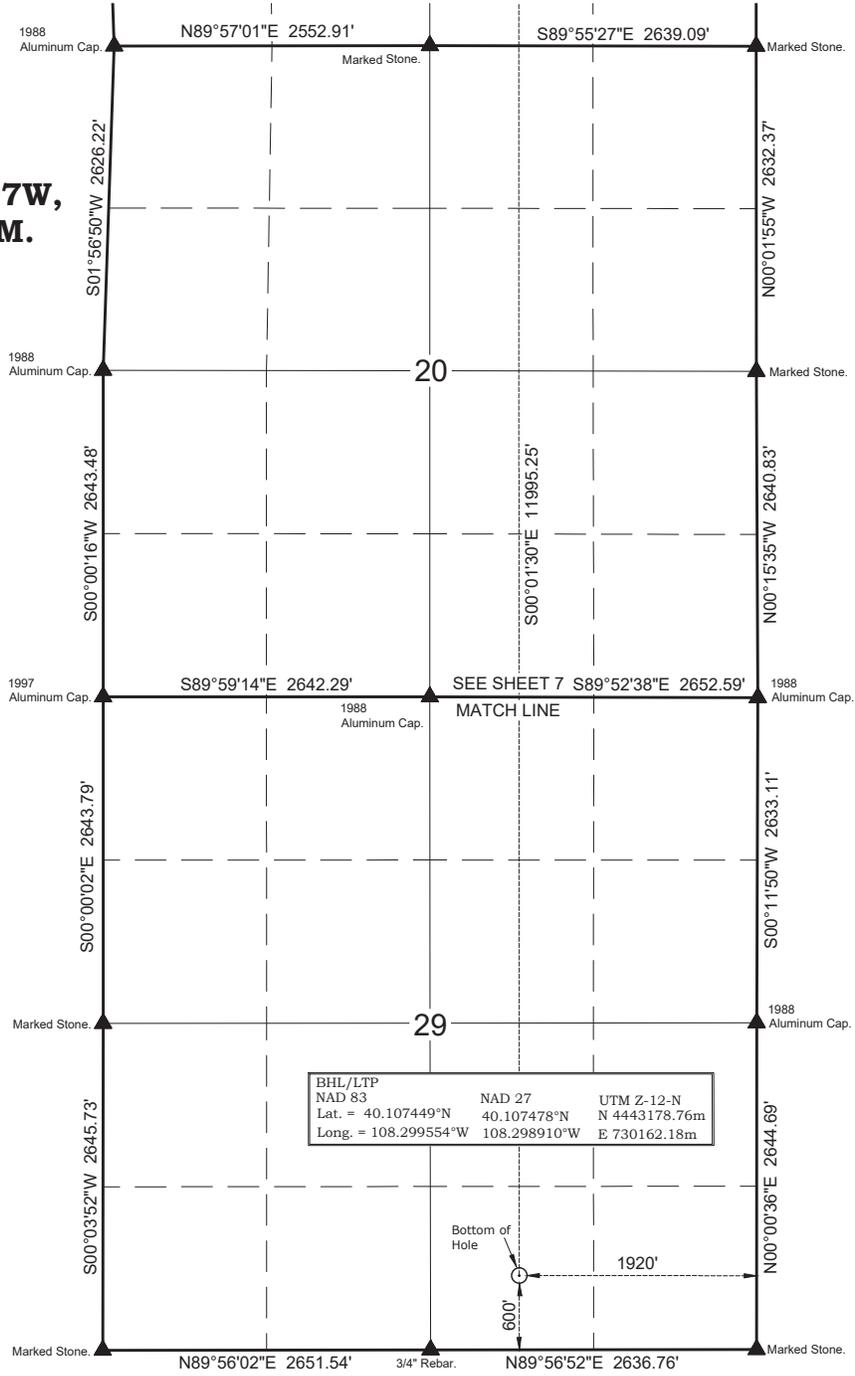

BHL/LTP	NAD 27	UTM Z-12-N
NAD 83	Lat. = 40.107449°N	N 4443178.76m
	Long. = 108.299554°W	E 730162.18m


**NOTES:**

- ▲ = Section Corners Located
- △ = Section Corners Located Not Monumented
- 1. Well footages are measured at right angles to the Section Lines.
- 2. Bearings and distances shown on this plat are based upon a local Cartesian Grid which is oriented to Geodetic North at the SE Corner of Section 36, T2N, R97W, 6th P.M. The grid having a mean project height of 6,250'. Lineal units used are U.S. Survey Foot. Trimble G.P.S. equipment was used in performance of this survey.
- 3. Latitude and Longitude are NAD 83 (2011) Epoch 2010. Elevations are NAVD 88. Which are derived from an NGS OPUS Report.

**ANSCHUTZ  
EXPLORATION CORPORATION**  
555 17th Street, Suite 2400 - Denver, Colorado 80202

**WELL PLAT**

**MOHEE FED 0297-17-29-15NH  
600' FSL & 1920' FEL (Bottom Hole)  
SW ¼ SE ¼ OF SECTION 29, T2N, R97W,  
6th P.M., RIO BLANCO COUNTY, COLORADO**

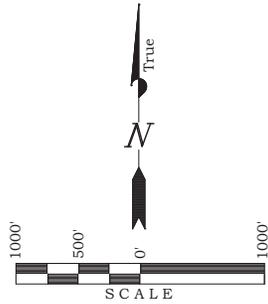

**SURVEYOR'S CERTIFICATE**

I, BROCK J. SLAUGH, DO HEREBY CERTIFY THAT I AM A PROFESSIONAL LAND SURVEYOR AND THAT I HOLD CERTIFICATE #38443 AS PRESCRIBED BY THE LAWS OF THE STATE OF COLORADO. I FURTHER CERTIFY THAT THIS PLAT AND ITS COMPUTATIONS AND FIELD SURVEYS NECESSARY FOR THE DATA COMPILED HEREON WERE MADE BY ME OR UNDER MY SUPERVISION AND THE SAME ARE TRUE AND CORRECT TO THE BEST OF MY KNOWLEDGE AND BELIEF; THAT THE SURVEY WAS PERFORMED IN ACCORDANCE WITH APPLICABLE STANDARDS OF PRACTICE AND I DO NOT MAKE A GUARANTY OR WARRANTY, EITHER EXPRESSED OR IMPLIED, THIS CERTIFICATE DOES NOT REPRESENT A LAND SURVEY PLAT OR IMPROVEMENT SURVEY PLAT AS DEFINED BY C.R.S. § 38-5-102 AND CANNOT BE RELIED UPON TO DETERMINE OWNERSHIP.




<b>TIMBERLINE</b>		
ENGINEERING & LAND SURVEYING, INC. 209 NORTH 300 WEST - VERNAL, UTAH 84078		
DATE SURVEYED: 7-11-23	SURVEYED BY: C.S.	SHEET
DATE DRAWN: 8-29-23	DRAWN BY: S.A.	<b>7A</b>
SCALE: 1" = 1000'	Date Last Revised: 9-27-23 S.A.	OF 39



WELL NAME	SHL			WELL NAME	LP/FTP		
	NAD 83				NAD 83		
	LATITUDE	LONGITUDE	FOOTAGES		LATITUDE	LONGITUDE	FOOTAGES
MOHEE FED 0297-17-29-16NH	40.143422°N	108.297264°W	2118' FNL 1261' FEL	MOHEE FED 0297-17-29-16NH	40.140365°N	108.294893°W	2040' FSL 600' FEL
MOHEE FED 0297-17-8-1NH	40.143461°N	108.297313°W	2104' FNL 1275' FEL	MOHEE FED 0297-17-8-1NH	40.143637°N	108.294989°W	2040' FNL 625' FEL
MOHEE FED 0297-17-29-16 WNH	40.143501°N	108.297363°W	2089' FNL 1289' FEL	MOHEE FED 0297-17-29-16 WNH	40.140366°N	108.295251°W	2040' FSL 700' FEL
MOHEE FED 0297-17-29-14NH	40.143540°N	108.297412°W	2075' FNL 1303' FEL	MOHEE FED 0297-17-29-14NH	40.140365°N	108.304258°W	2040' FSL 2040' FWL
MOHEE FED 0297-17-29-15 WNH	40.143580°N	108.297462°W	2061' FNL 1317' FEL	MOHEE FED 0297-17-29-15 WNH	40.140367°N	108.299970°W	2040' FSL 2020' FEL
MOHEE FED 0297-17-8-3NH	40.143620°N	108.297512°W	2046' FNL 1331' FEL	MOHEE FED 0297-17-8-3NH	40.143635°N	108.304339°W	600' FSL 2040' FWL
MOHEE FED 0297-17-29-15NH	40.143659°N	108.297561°W	2032' FNL 1344' FEL	MOHEE FED 0297-17-29-15NH	40.140367°N	108.299613°W	2040' FSL 1920' FEL
MOHEE FED 0297-17-8-2NH	40.143699°N	108.297611°W	2017' FNL 1358' FEL	MOHEE FED 0297-17-8-2NH	40.143636°N	108.299619°W	2040' FNL 1920' FEL

WELL NAME	BLH/LTP		
	NAD 83		
	LATITUDE	LONGITUDE	FOOTAGES
MOHEE FED 0297-17-29-16NH	40.107455°N	108.294837°W	600' FSL 600' FEL
MOHEE FED 0297-17-8-1NH	40.162084°N	108.294923°W	600' FNL 600' FEL
MOHEE FED 0297-17-29-16 WNH	40.107455°N	108.295194°W	600' FSL 700' FEL
MOHEE FED 0297-17-29-14NH	40.107442°N	108.304300°W	600' FSL 2040' FWL
MOHEE FED 0297-17-29-15 WNH	40.107448°N	108.299912°W	600' FSL 2020' FEL
MOHEE FED 0297-17-8-3NH	40.162089°N	108.304359°W	600' FSL 2040' FWL
MOHEE FED 0297-17-29-15NH	40.107449°N	108.299554°W	600' FSL 1920' FEL
MOHEE FED 0297-17-8-2NH	40.162086°N	108.299645°W	600' FNL 1920' FEL

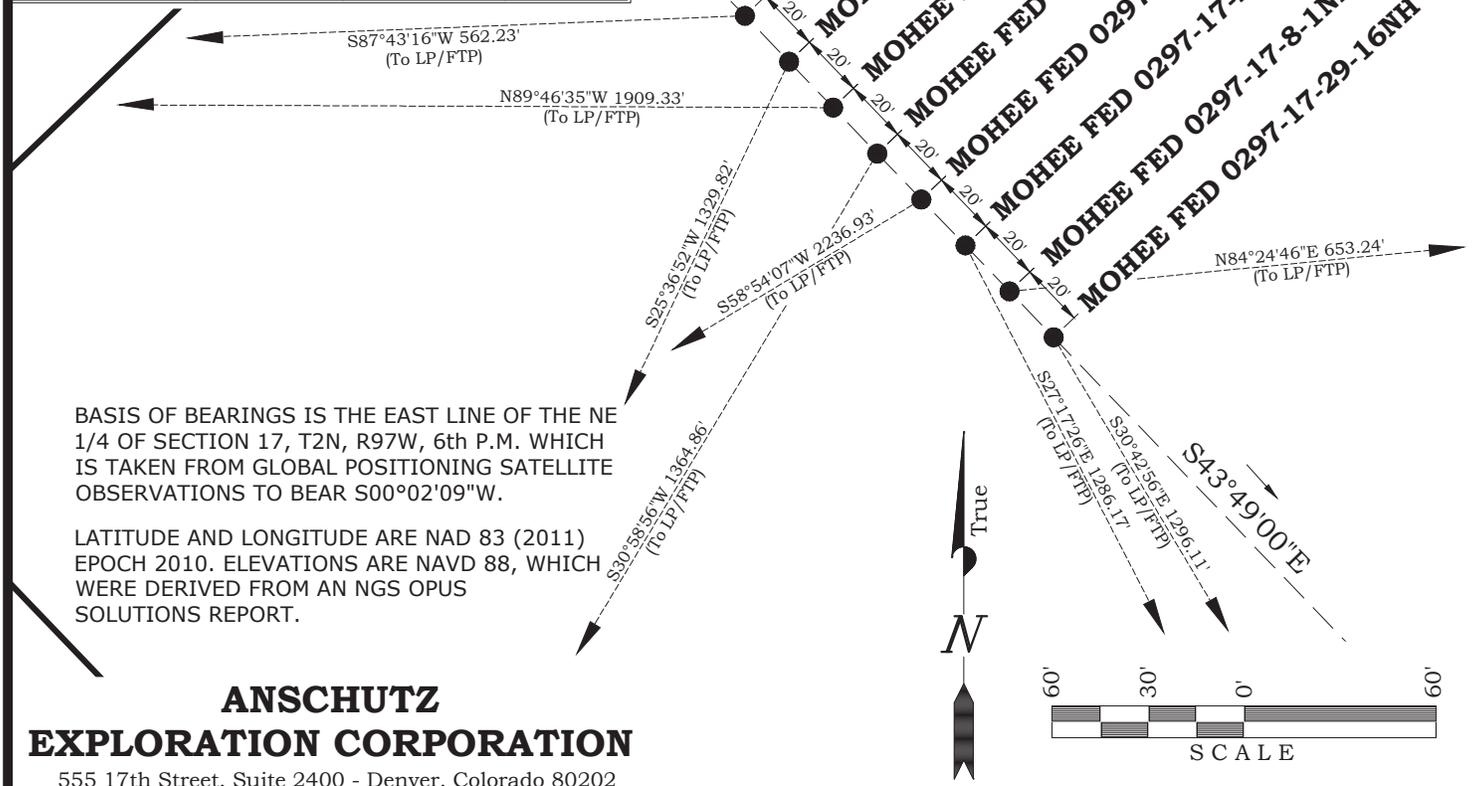

**ANSCHUTZ**  
**EXPLORATION CORPORATION**  
 555 17th Street, Suite 2400 - Denver, Colorado 80202

**DIRECTIONAL WELL PLAT**

**MOHEE FED 0297-17**  
 LOCATED IN SW/NE OF SECTION 17, T2N, R97W,  
 6th P.M., RIO BLANCO COUNTY, COLORADO

**TIMBERLINE** (435) 789-1365

ENGINEERING & LAND SURVEYING, INC.  
 209 NORTH 300 WEST - VERNAL, UTAH 84078

DATE SURVEYED: 7-11-23	SURVEYED BY: C.S.	SHEET <b>9</b> OF 39
DATE DRAWN: 8-29-23	DRAWN BY: S.A.	
SCALE: 1" = 60'		Date Last Revised: 12-11-23 S.A.