



FORM F-106




00264914

RECEIVED

OCT 1 1974

COLO. OIL & GAS CONS. COMM.

R. 56W

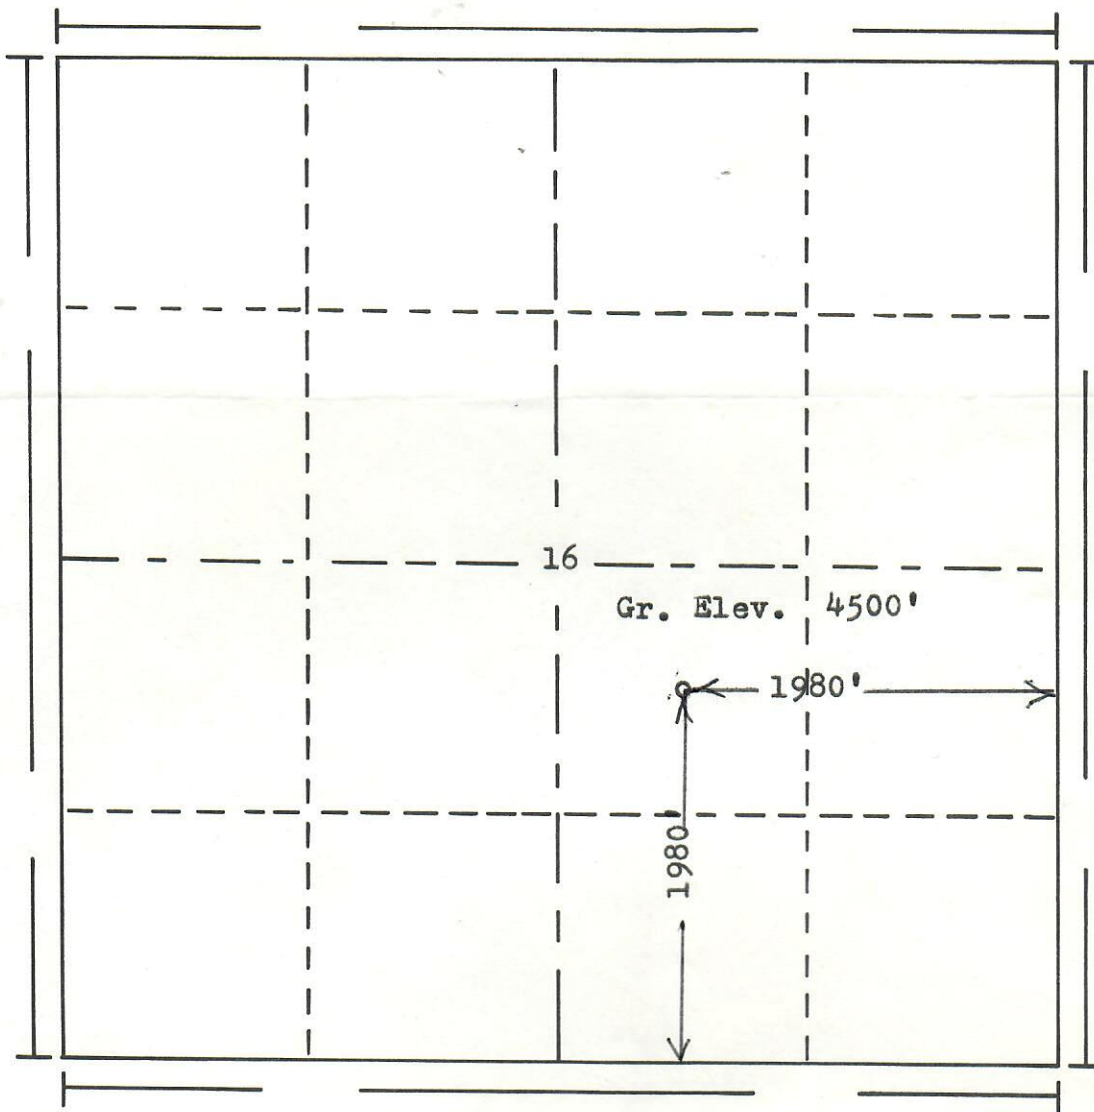

T. 9N

Scale... 1" = 1000'

Powers Elevation Company, Inc. of Denver, Colorado
has in accordance with a request from Michelle
for Robert Schulein & Exeter Drlg. & Exploration Co.
determined the location of No.1 Walsh- State
to be CNW SE Section 16 Township 9N
Range 56W of the 6th Principal Meridian
Weld County, Colorado

I hereby certify that this plat is an
accurate representation of a correct
survey showing the location of

Date: 9-17-74

Billy G. Sullivan
Licensed Land Surveyor No. 2853
State of Colorado