




00789296

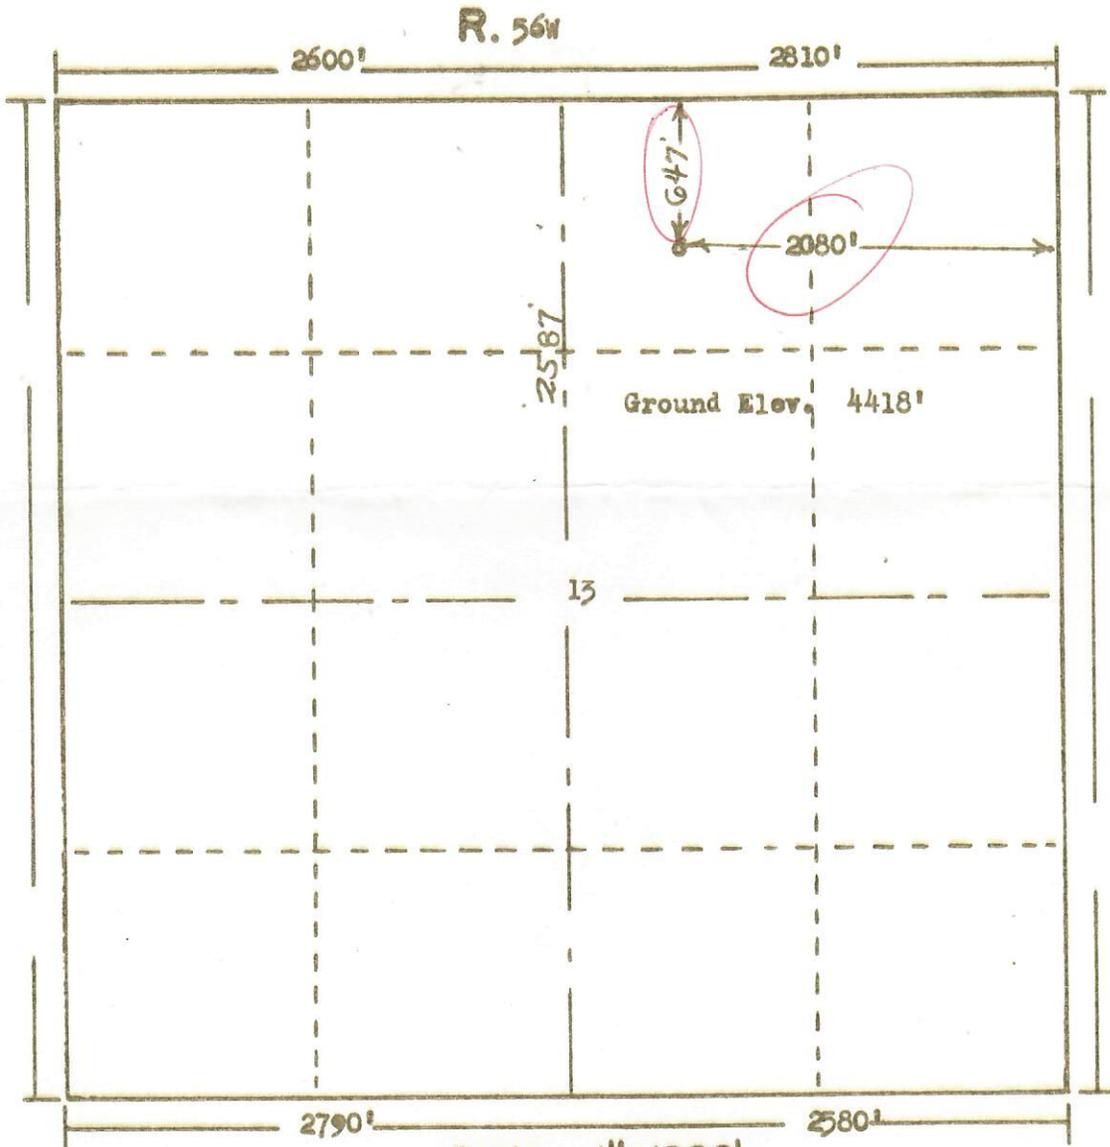

T.  
9N

Scale ... 1" = 1000'

Powers Surveyors, Inc. of Denver, Colorado  
 has in accordance with a request from Mr. Gaseh  
 for Toltek Drlg. Co. & Tom Jessels determined the  
 Location of No. 1 Darland Trust  
 to be CNW NE Section 13 Township 9N  
 Range 56W of the 6th Principal Meridian  
 Weld County, Colorado

REGISTERED  
 AUG 23 1966  
 OIL & GAS  
 CONSERVATION COMMISSION

I hereby certify that this plat is an  
 accurate representation of a correct  
 survey showing the location of

66-323

Date: 8-19-66

B. G. Holloway  
 Licensed Land Surveyor No. 2853  
 State of Colorado