




CABERN STATE #1  
NENE 36 TPN RSS

	QTR	QTR	SEC	TWNS	RANGE	PM	NAME	DEPTH	TPERF	BPERF
A	NE	SW	15	090N	0550W	S	COLE RALPH A	710		
B	SW	SE	17	090N	0550W	S	LOWEN DAN	146		
C	SW	SE	17	090N	0550W	S	LOWEN DAN	146		
D	NE	NE	21	090N	0550W	S	LOWEN DAN	760		
E	NE	NW	21	090N	0550W	S	RIVONKA NAOMI JEAN & DAN	548		
F	NW	NW	23	090N	0550W	S	MATTHEWSON STEVEN E	805	646	805
G	NE	NW	27	090N	0550W	S	BUDIN HELEN	835	335	835
H	SE	SE	29	090N	0550W	S	PIVONKA DAN	34		
I	NW	NW	30	090N	0550W	S	NICKLAS JOHN	5667		
J	NW	SW	31	090N	0550W	S	SNYDER RODNEY M			
K	NE	NE	32	090N	0550W	S	GEIST RANCHES INC.	505		
L	NE	NE	34	090N	0550W	S	KYLE RILEY J	500		
M	SW	NE	36	090N	0550W	S	CO BOARD LAND COMMISSIONERS	534		
N		NW	36	090N	0550W	S	U S AIR FORCE			
O		SE	36	090N	0550W	S	US AIR FORCE			
P		SW	36	090N	0550W	S	US AIR FORCE			
Q	SW	SW	36	090N	0550W	S	US AIR FORCE	764		
R	SW	SW	36	090N	0550W	S	KNUDSON JACK B			
S	SW	SW	36	090N	0550W	S	US AIR FORCE			
T	SW	NW	01	090S	0550W	S	SELF WALTER			

Letter=Choice | F10=Mark 1 | PgUp/PgDn=±20 | UpAr/DnAr =±1 | Esc=Quit

OIL AND GAS WELL/WATER WELL

BASE PLAT

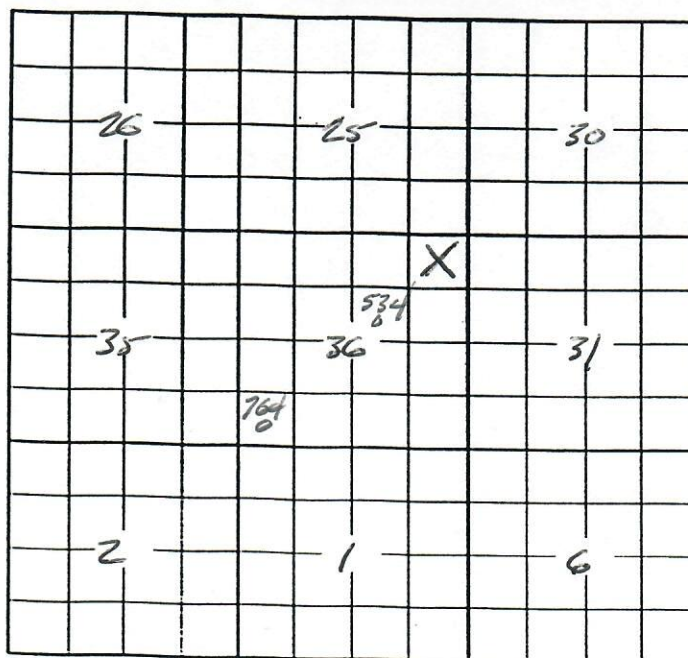



# INDUCTION ELECTROLOG

FILE NO.	COMPANY	REGENTIA CORPORATION	RECEIVED
WELL	NO. 1 - 25 LIFT	MAR 28 1986	
FIELD	BINGO		
COUNTY	LOZOS		
LOCATION:	16		
THANKS !	SEC25	TRIP 9 N	RCESS M
PERMANENT DRUM	G.L.	ELEV. 4433.5	ELEVATIONS
LOGGING MEASURED FROM	K.B.	9	FT. ABOVE P.D.
DRILLING MEASURED FROM	K.B.		OF 4433.5
DATE	10 APR 86		
SERVICE ORDER	98126		
DEPTH-DRILLER	5500		
DEPTH-LOGGER	5500		
SECTION LOGGED INTERVAL	54/58		
TOP LOGGED INTERVAL	OSC.		
LOGGING - DRILLER	8 5/8	1.40	
LOGGING - LOGGER	1 3/8	1.70	
BIT SIZE	7/8		
TYPE FLUID IN HOLE	DETH-OL	6.7	
DENSITY / VISCOSITY	9.9	5.2	
PH / FLUID LOSS	8.0		
SOURCE OF SAMPLE	MUDPIT		
AT MESS. TEMP.	4.20	1.60	
AT MESS. TEMP.	3.15	1.60	
AT MESS. TEMP.	5.25	1.60	
SOURCE OF REF / RHC	ORL.	1.47	
AT BIT	1.71		
TIME SINCE CIRCULATION	3 HOURS		
MAX. REC. TEMP. DEG. F	147		
EQUIP. NO. / LOC.	6401 (L41)	FT. MORGAN	
RECORDED BY	J.M. DROOK		
WITNESSED BY	TOM FLEIDER		

FOLD HERE

IN MAKING INTERPRETATIONS OF LOSS OF EMPLOYEES WILL GIVE CUSTOMER THE BEST FIT OF THEIR BEST JUDGMENT, BUT SINCE ALL INTERPRETATIONS ARE OPINIONS BASED ON INFERENCE FROM ELECTRICAL OR OTHER MEASUREMENTS, WE CANNOT, AND WE DO NOT GUARANTEE THE ACCURACY OR CORRECTNESS OF ANY INTERPRETATION. WE SHALL NOT BE LIABLE OR RESPONSIBLE FOR ANY LOSS, COST, DAMAGES, OR EXPENSES WHATSOEVER INCURRED OR SUSTAINED BY THE CUSTOMER RESULTING FROM ANY INTERPRETATION MADE BY ANY OF OUR EMPLOYEES.


REMARKS RUN ( 1 )

## EQUIPMENT DATA

RUN	TRIP	TOOL	SERIAL NO.	SERIES NO.	POSITION
1	1	DIFL	60069	1503	FREE
1	1	GR			
1	1	CAL			

.....  
• CALIBRATION/VERIFICATION SUMMARIES  
• DATE 03/10/86 TIME 01:31:21  
• RUN 1 TRIP 1  
•.....

5000  
SP (MV)  
0 200

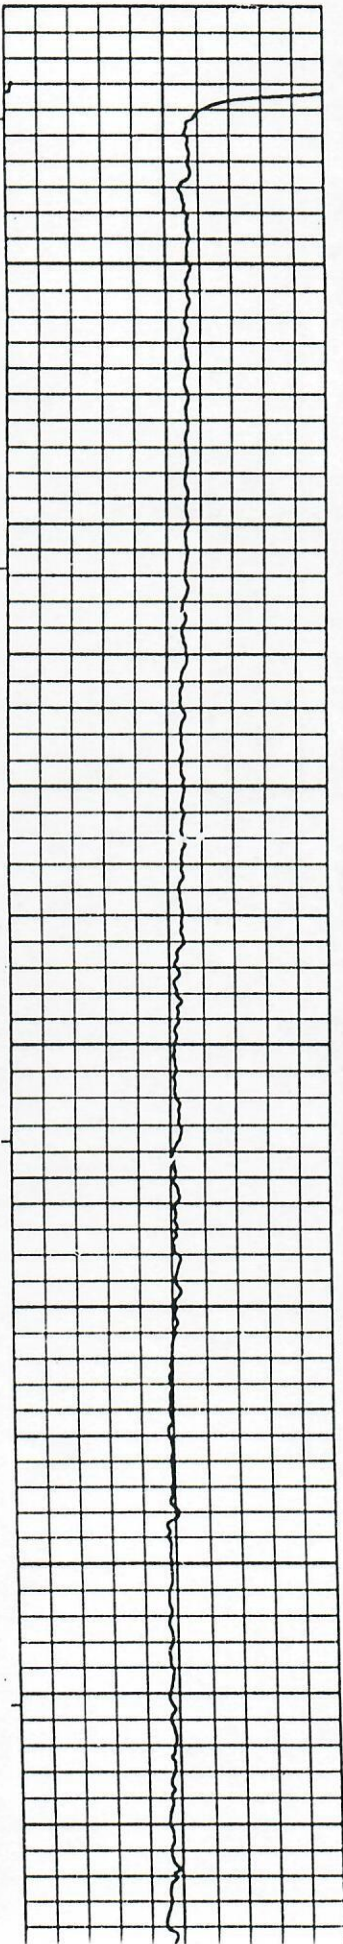

50  
CILD (M1+0)  
1000 0

