


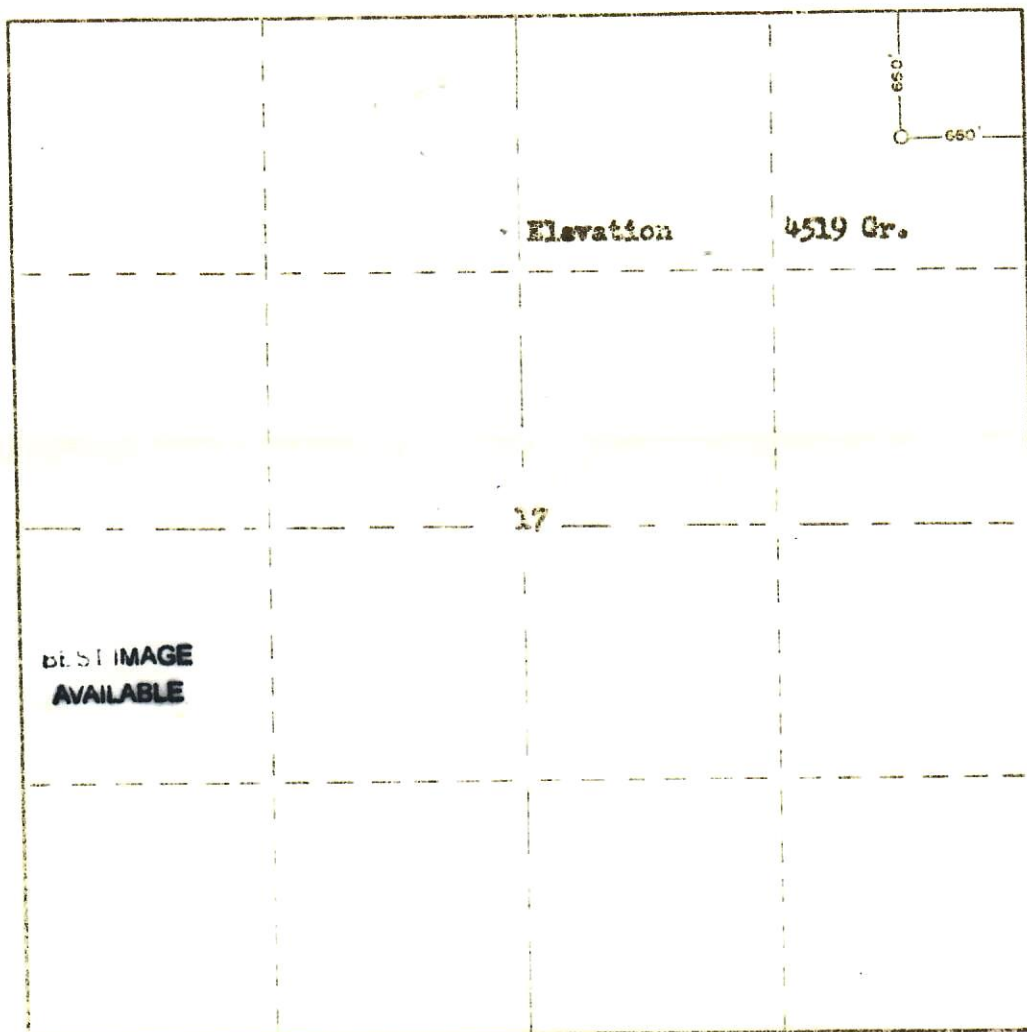


00271182

R. 36 W.

T.
9
N.

Scale 1"=1000'

Powers Elevation Company of Casper, Wyoming
has in accordance with a request from Mr. Stude
for Halbert & Jennings determined the
Location of 21 Flag
to be 6 NE 1/4 Section 17 Township 9 North
Range 36 West 6th Principal Meridian
Hall County, Colorado

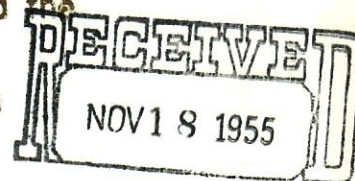

The above Plat shows the location of the well site
in said section.

Powers Elevation Company
by: *Robert Halbert*
Registered Land Surveyor

Date 11-11-55

