



FORM F-106

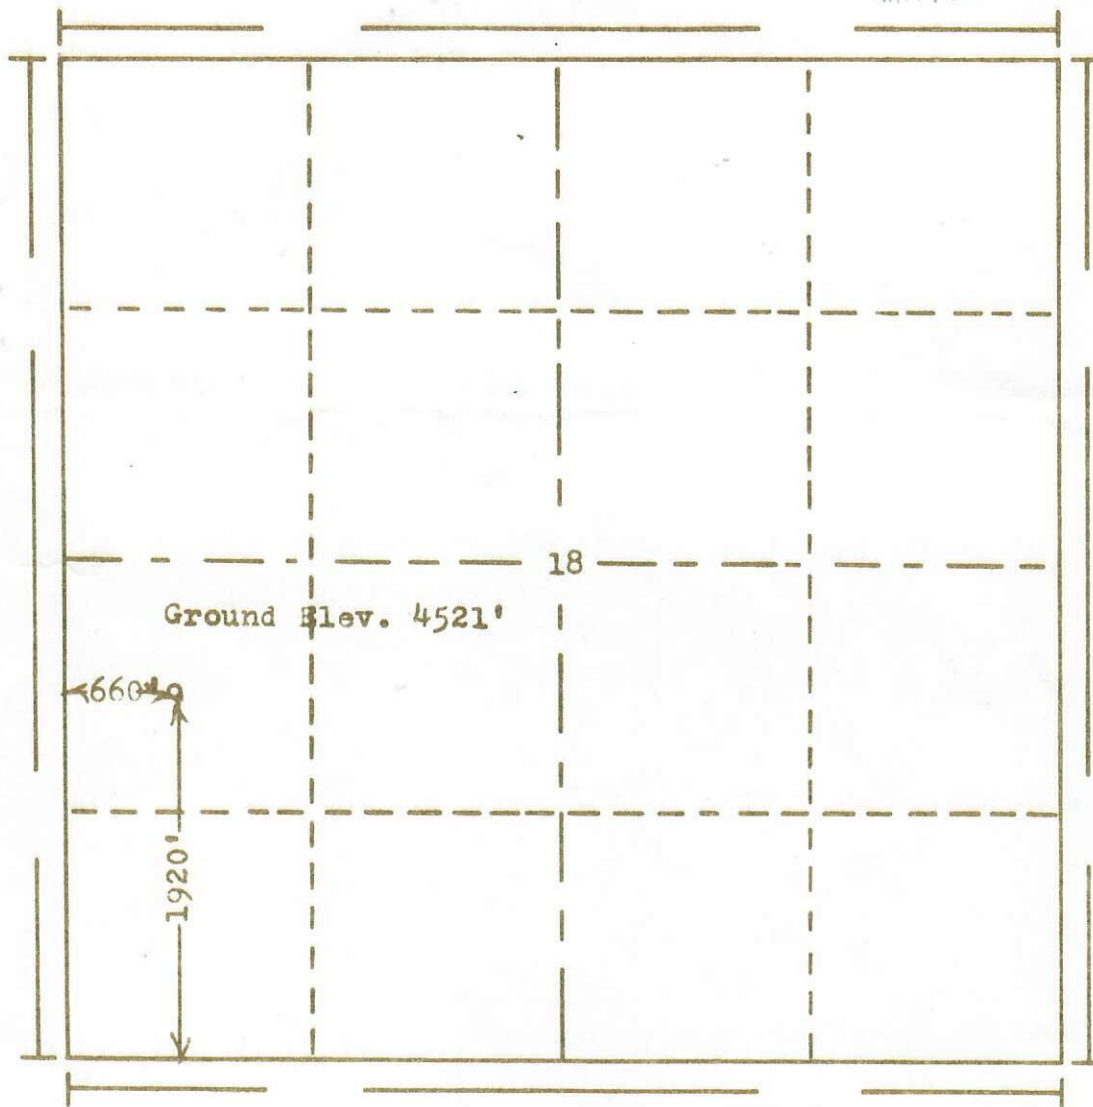


RECEIVED

OCT 29 1973

OIL, OIL & GAS CO-ES. COMM.

R. 56W

T.
9
N

Scale... 1" = 1000'

Powers Elevation Company, Inc. of Denver, Colorado
has in accordance with a request from Mr. Gear
for Dyco Petroleum Corp.

determined the location of No. 1 Lousberg
to be 60' South of CNW SW Section 18 Township 9N
Range 56W of the 6th Principal Meridian
Weld County, Colorado

I hereby certify that this plat is an
accurate representation of a correct
survey showing the location of

Date. 10-16-73

B. G. H. H. H.
Licensed Land Surveyor No. 2853
State of Colorado