

Lousberg # 1


NWSW Sec 18, T 9W R 56W  
Weld County, Colorado



RECEIVED

NOV 13 01

COGCC

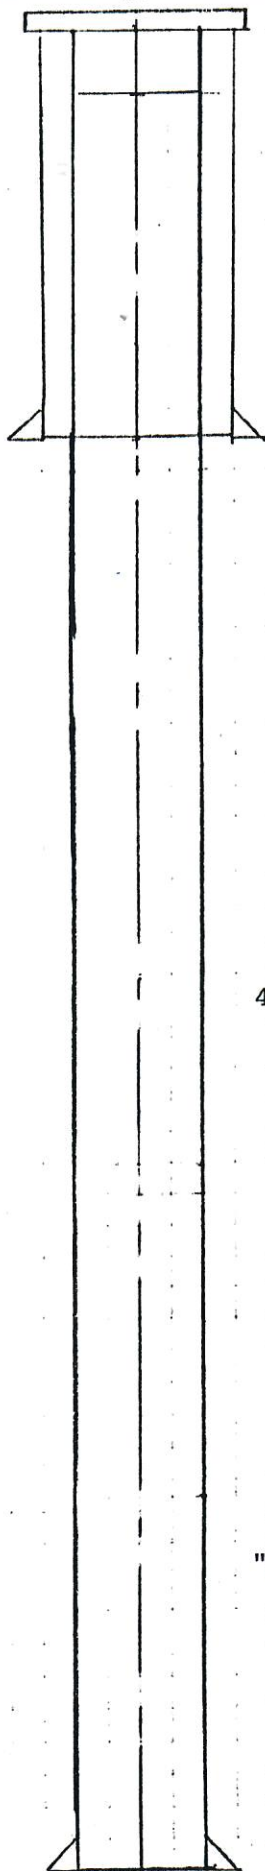

8 5/8" Surface Casing @92'w/80 sx

4 1/2" Production Casing

"J" Sand Perfs 5918-22'

4 1/2" Casing @5987' w/175 sx