


OIL AND GAS CONSERVATION COMMISSION OF THE STATE OF COLORADO

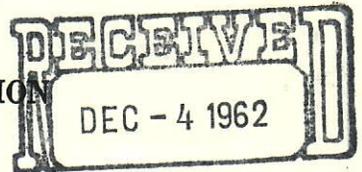

NOTICE OF INTENTION TO DRILL

OIL & GAS CONSERVATION COMMISSION


INSTRUCTIONS:

A notice of intention to drill a well shall be filed in duplicate on all Federal and Patented lands, and in triplicate on all State lands. Do not begin operations until approved copy has been received. It is mandatory that the proposed location comply with all rules and regulations of the Commission. Locate well on section grid in proper location, and indicate extent of lease. Unless operations are commenced within 180 days after the date of approval hereof, this approval to drill will become null and void.

Name of Operator Juniper Oil and Mining Company Phone No. 222-7797
Address 420 C. A. Johnson Building City Denver 2 State Colorado

How is liability secured: Well Bond (Attached) [ ]; Blanket Bond [X]; Waiver [ ]
(Choose one)

Lease Name McKenzie, et al
Well No. 1
Field Name Wildcat [X]
County Weld

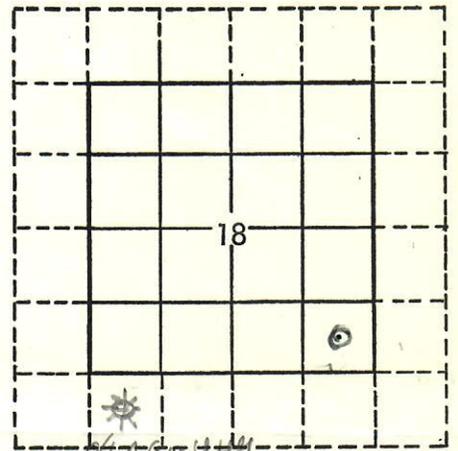

Location SE 1/4 SE 1/4 Section 18 Township 9N Range 56W Meridian 6th P.M.
655 feet from S Section line and 660 feet from E Section Line

The well is located on: Patented land [X] State land [ ] Federal land [ ]

The well is located within a spaced area: Yes [ ] No [X]

Distance from proposed location to nearest property or lease line 655 feet.
Distance from proposed location to nearest drilling unit line --- feet.

Objectives: "D" sand Formation Depth 5750' Estimate; "J" Formation Depth 5830' Estimate

Proposed length of surface casing 175' feet.

REMARKS:

Table with columns for Agent, Bond, Depth (600 ft, 1200 ft), Wells (Oil, Gas), and Status. Includes handwritten 'Blanket' and 'Ph. No. 12/19/62'.

I/We hereby swear (or affirm) that the statements herein made are a full and correct report.

APPROVED: Date DEC - 4 1962
Signature of Deputy Director

Company Juniper Oil & Mining Company Date 12/3/62
Address 420 C. A. Johnson Building Phone No. 222-7797
By Charles J. Lyden Title Landman
Signature of Charles J. Lyden