




00241775

OIL AND GAS CONSERVATION COMMISSION OF THE STATE OF COLORADO

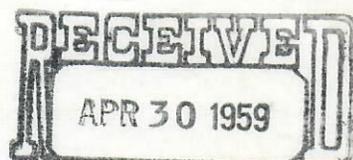

OIL & GAS CONSERVATION COMMISSION

NOTICE OF INTENTION TO DRILL


INSTRUCTIONS:

A notice of intention to drill a well shall be filed in duplicate on all Federal and Patented lands, and in triplicate on all State lands. Do not begin operations until approved copy has been received. It is mandatory that the proposed location comply with all rules and regulations of the Commission. Locate well on section grid in proper location, and indicate extent of lease. Unless operations are commenced within 180 days after the date of approval hereof, this approval to drill will become null and void.

Name of Operator MIAMI PETROLEUM COMPANY, INC. Phone No. ORchard 4-6253
Address P. O. Drawer 2040 City Abilene State Texas

How is liability secured: Well Bond (Attached) [ ]; Blanket Bond [ ]; Waiver [X] (Check one)

Lease Name W. J. CRAIG "B"
Well No. 1
Field Name Wildcat [X]
County Weld

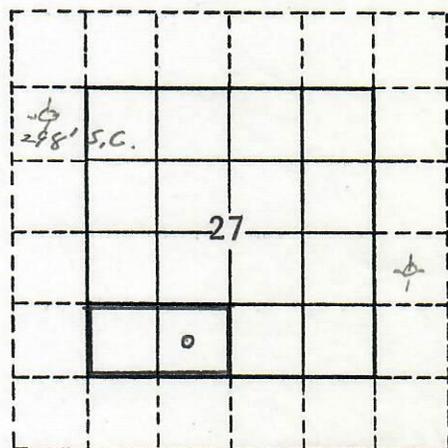

Location SE SW Section 27 Township 9 N Range 56W Meridian Sixth
660 (quarter quarter) feet from S Section line and 1992 feet from W Section Line
N or S E or W

The well is located on: Patented land [X] State land [ ] Federal land [ ]

The well is located within a spaced area: Yes [X] No [ ]

Distance from proposed location to nearest property or lease line 660 feet.
Distance from proposed location to nearest drilling unit line None feet.

Objectives: Skull Creek Formation Depth 5900 Estimate; Formation Depth Estimate

Proposed length of surface casing 250 feet.

REMARKS:

ELEVATION - 4453' G.L.

Table with columns: Agent, Bond, Spot, Wells, Oil, Gas, Status. Includes handwritten 'OK' and 'waived'.

I/We hereby swear (or affirm) that the statements herein made are a full and correct report.

APPROVED: Date MAY - 1 1959 Director [Signature]

Company MIAMI PETROLEUM CO. INC Date April 28, 1959
Address P. O. Drawer 2040 Abilene, Texas Phone No. OR-4-6253
By Jack Stivers Signature Title Vice President