



FORM F-106




00271406

RECEIVED

MAY 3 1972

R. 56W COLO. OIL & GAS CONS. COMM.

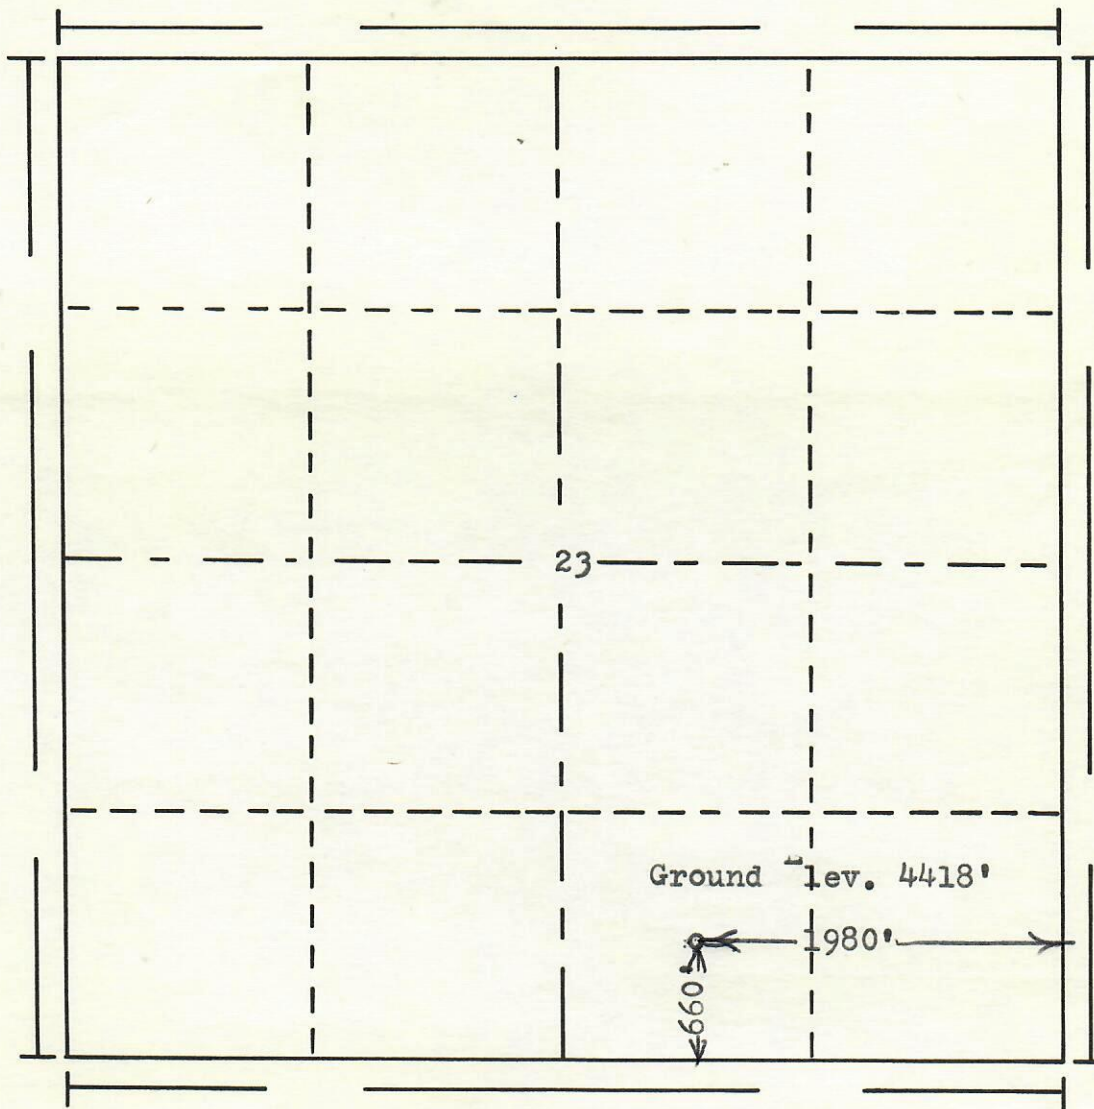

T. 9N

Scale... 1" = 1000'

Powers Elevation Company, Inc. of Denver, Colorado
has in accordance with a request from Michelle
for Maggie Oil & Exeter Drlg. & Exploration Co.
determined the location of No. ? ?

to be CSW SE Section 23 Township 9N
Range 56W of the 6th Principal Meridian
Weld County, Colorado

I hereby certify that this plat is an
accurate representation of a correct
survey showing the location of

Date: 4-21-72

B. G. Holloway
Licensed Land Surveyor No. 2853
State of Colorado