



FORM F-106



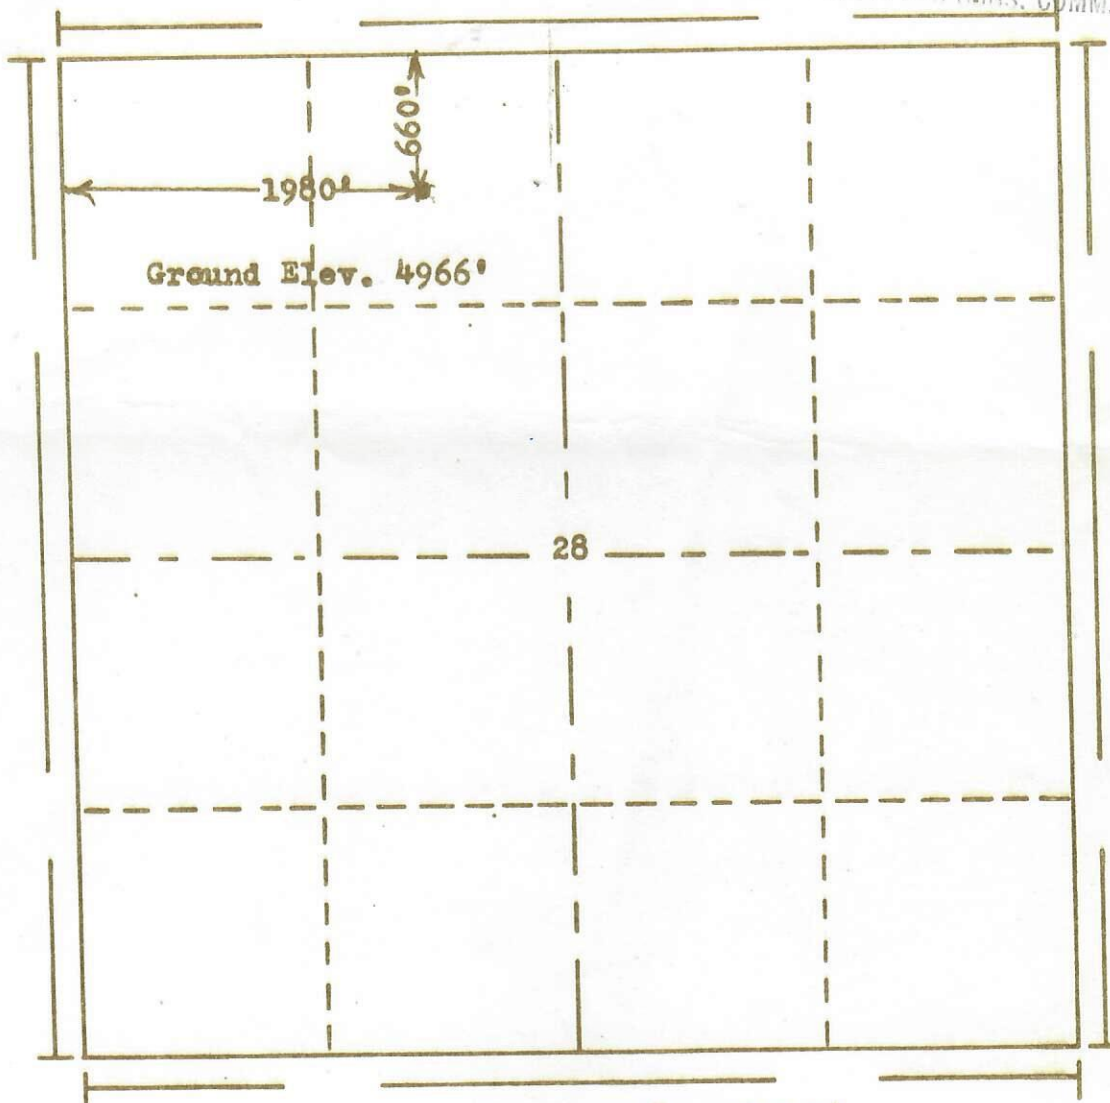
00217115

RECEIVED

NOV 19 1971

R. 67W

COLD, OIL &amp; GAS COMS. COMM.

T.  
7  
N

Scale... 1" = 1000'

Powers Elevation Company, Inc. of Denver, Colorado  
has in accordance with a request from Mr. Brooks  
for Brooks Exploration Co. & Blake Oil Co.  
determined the location of No. 1 George Nelson  
to be CNE NW Section 28 Township 7N  
Range 67W of the 6th Principal Meridian  
Weld County, Colorado

I hereby certify that this plat is an  
accurate representation of a correct  
survey showing the location of

Date: 11-15-71

Eric G. Hoffman  
Licensed Land Surveyor No. 2853  
State of Colorado