



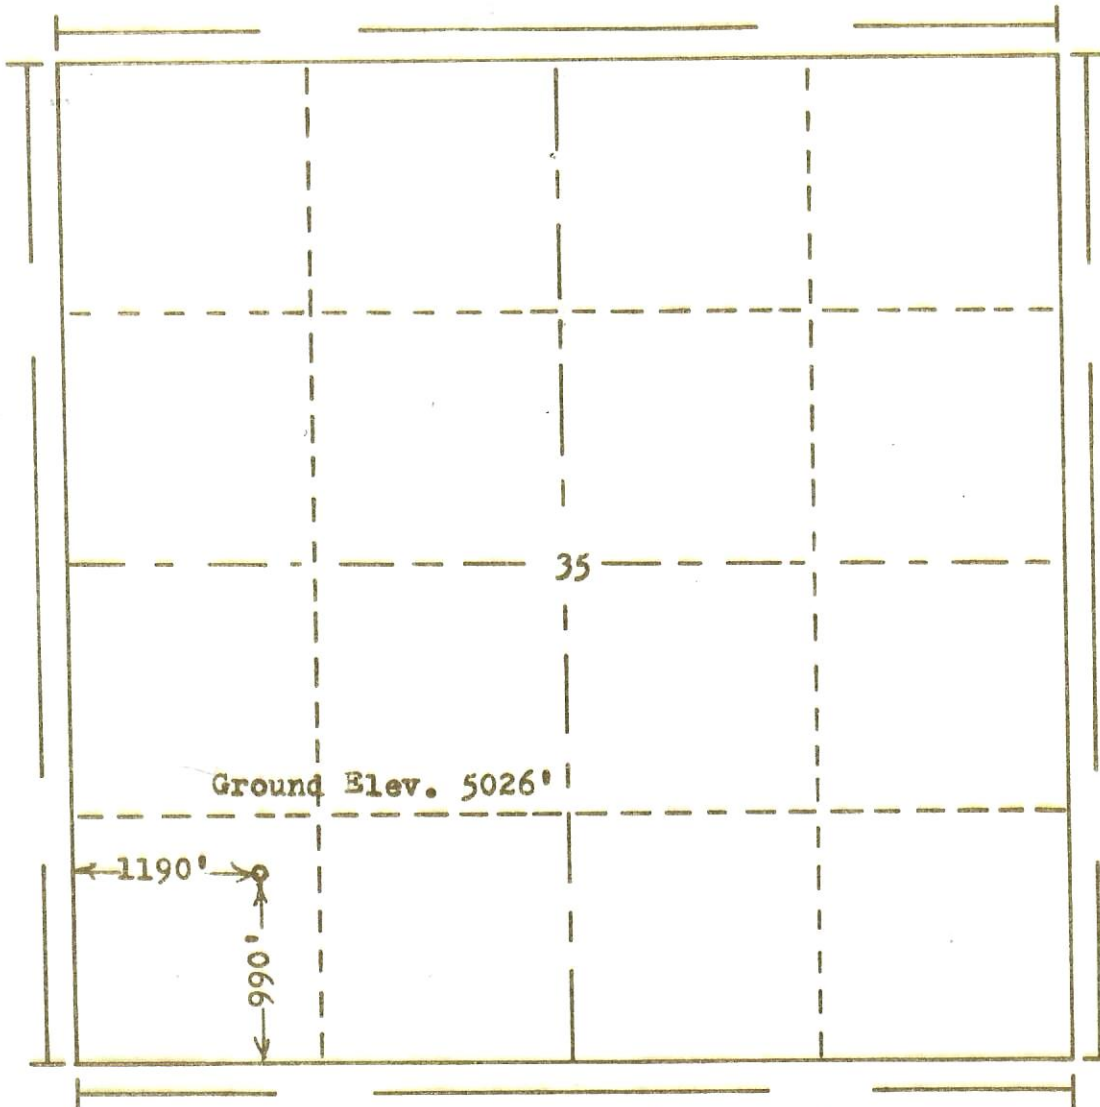
FORM F-106

RECEIVED

MAR 25 1974

OIL &amp; GAS CONS. COMM.

R. 67W

T.  
1  
N

Scale... 1" = 1000'

Powers Elevation Company, Inc. of Denver, Colorado  
has in accordance with a request from Mr. Sucke  
for Amoco Production Co.

determined the location of No. 1 Noel Hubert Unit  
to be 990'PS & 1190'FW Section 35 Township 1N  
Range 67W of the 6th Principal Meridian  
Weld County, Colorado

I hereby certify that this plat is an  
accurate representation of a correct  
survey showing the location of

Date: 3-14-74

B. J. H. H.  
Licensed Land Surveyor No. 2853  
State of Colorado



00036312

74-181