


WELL NAME:	ALAMOSA 5-64 6-1 1BH				OPERATOR:	CRESTONE PEAK RESOURCES	
FIELD:	DJ HORIZONTAL NIOBRARA				FORMATION:	Niobrara	
SHL:	qtr-qtr	NENE	Section 6	Township	5S	Range	64W
BHL:	qtr-qtr	LOT 2	Section 1	Township	5S	Range	65W
COUNTY:	ARAPAHOE		STATE:	CO		API:	05-005-07524-00

not to scale	
GROUND LEVEL:	5997
KELLY BUSHING:	6022
SPUD DATE:	4/30/2023
TD DATE:	5/5/2023

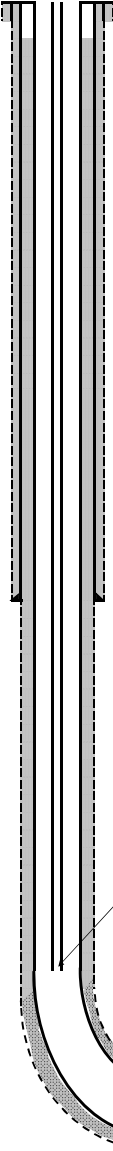

CONDUCTOR CASING	
SIZE:	16
WEIGHT:	42#
HOLE SIZE:	26
CSG DEPTH:	124
CEMENT:	114 SKS
TOC:	SURFACE

SURFACE CASING	
SIZE:	9-5/8"
WEIGHT:	36#
HOLE SIZE:	13-1/2"
HOLE DEPTH:	3,355
CSG DEPTH:	3,355
CEMENT:	1477 SKS
TOC:	SURFACE

PRODUCTION CASING	
SIZE:	5-1/2"
WEIGHT:	20#
HOLE SIZE:	8-1/2"
TOTAL DEPTH TVD	8,131
TOTAL DEPTH MD	18,608
CSG DEPTH:	18,603
CEMENT:	2840 SKS
TOC:	215

PRODUCTION TUBING	
SIZE:	2-3/8"
WEIGHT:	4.7#
DEPTH:	8,061
PACKER DEPTH:	8,059

EOT @ 8061

FORMATION TOPS & PERFORATIONS		
NIOBRARA MD	7,856	
<hr/>		
PERFORATIONS	8,430	18,451

FRAC DATA	
455,367	BBLS GELLED FLUID
4,167	BBLS ACID
22,143	BBLS FRESH WATER
481,677	BBLS TOTAL FLUID

0	# 30/50 MESH
2,923,242	# 40/70 MESH
8,699,363	# 100 MESH
11,622,605	# TOTAL SAND
59	STAGES

Production Csg @ 18603'

MD TD 18,608