




FORM F-106

RECEIVED

JUL 2 1973

COLD. OIL & GAS CONS. COMM.

R. 67W

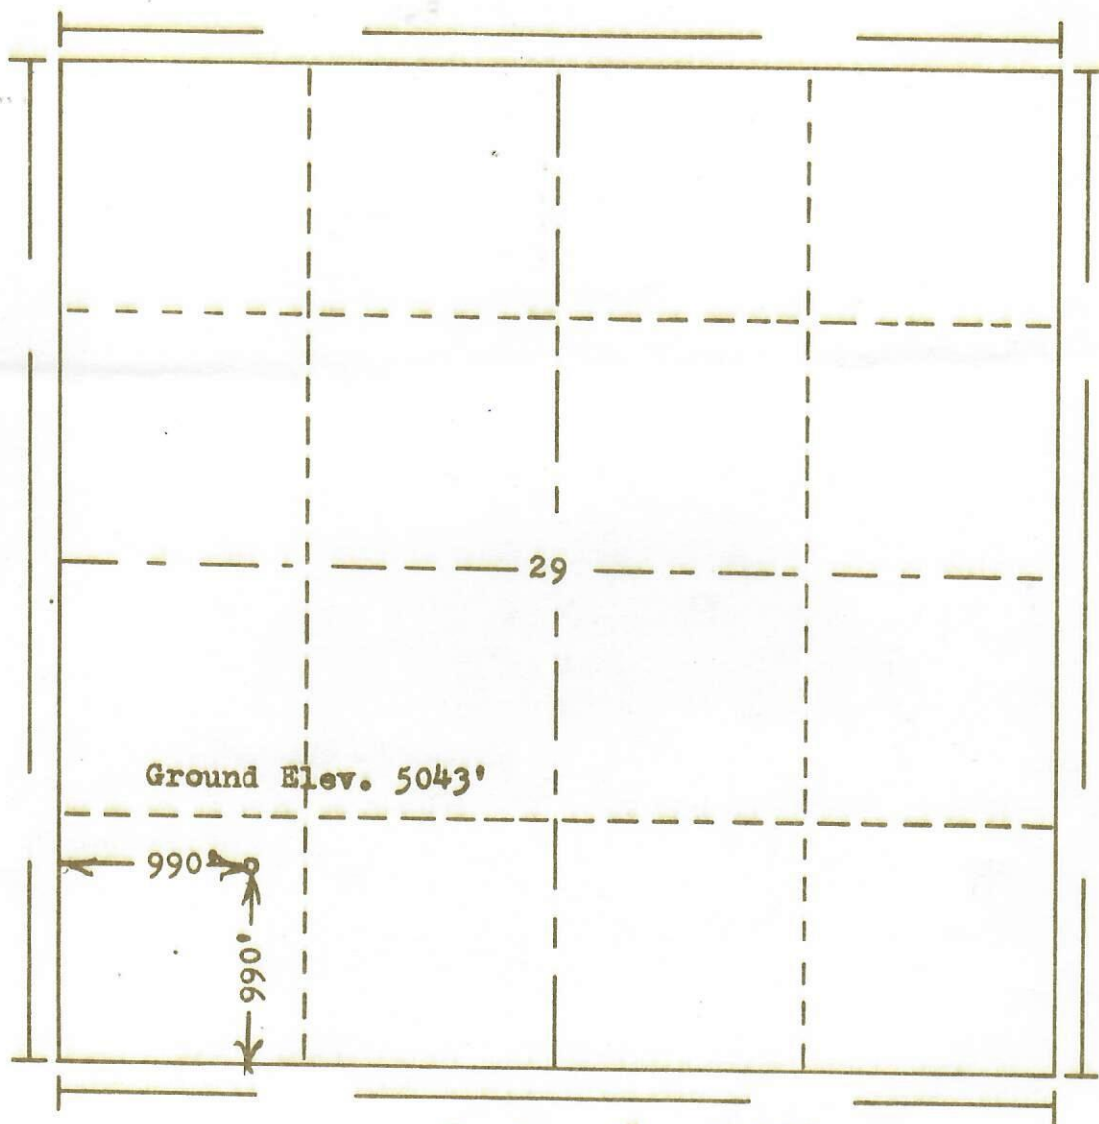

Scale... 1" = 1000'

Powers Elevation Company, Inc. of Denver, Colorado
has in accordance with a request from Mr. McMillan
for Amoco Production Co.

determined the location of No. 43 UPRR-Pan Am D-1
to be CNE SW SW Section 29 Township 1N
Range 67W of the 6th Principal Meridian
Weld County, Colorado



I hereby certify that this plat is an
accurate representation of a correct
survey showing the location of

Date: 6-19-73

Rein. J. Hallman
Licensed Land Surveyor No. 2853
State of Colorado