




FORM F-106

RECEIVED

JUN 4 1976

COLO. OIL & GAS CONS. COMM.

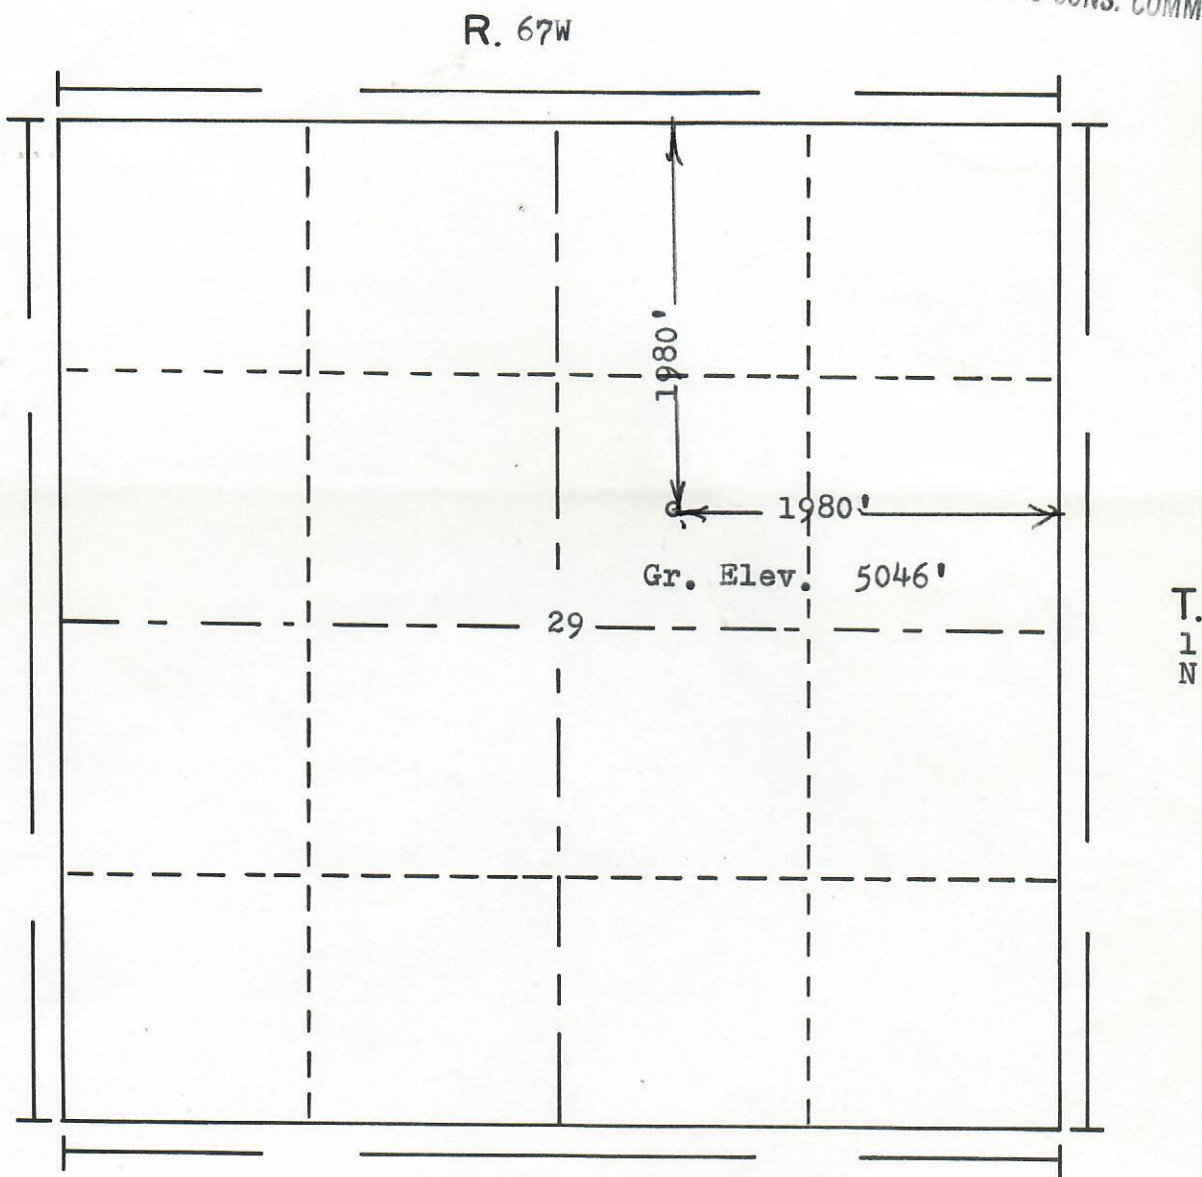

Powers Elevation Company, Inc. of Denver, Colorado
has in accordance with a request from Mr. Stubblefield
for Champlin Petroleum Co.
determined the location of No. 3 Zarlengo
to be CSW NE Section 29 Township 1N
Range 67W of the 6th Principal Meridian
Weld County, Colorado



50000135

I hereby certify that this plat is an
accurate representation of a correct
survey showing the location of

Date: 5-29-76

B. J. Hollman
Licensed Land Surveyor No. 2853
State of Colorado

76 439