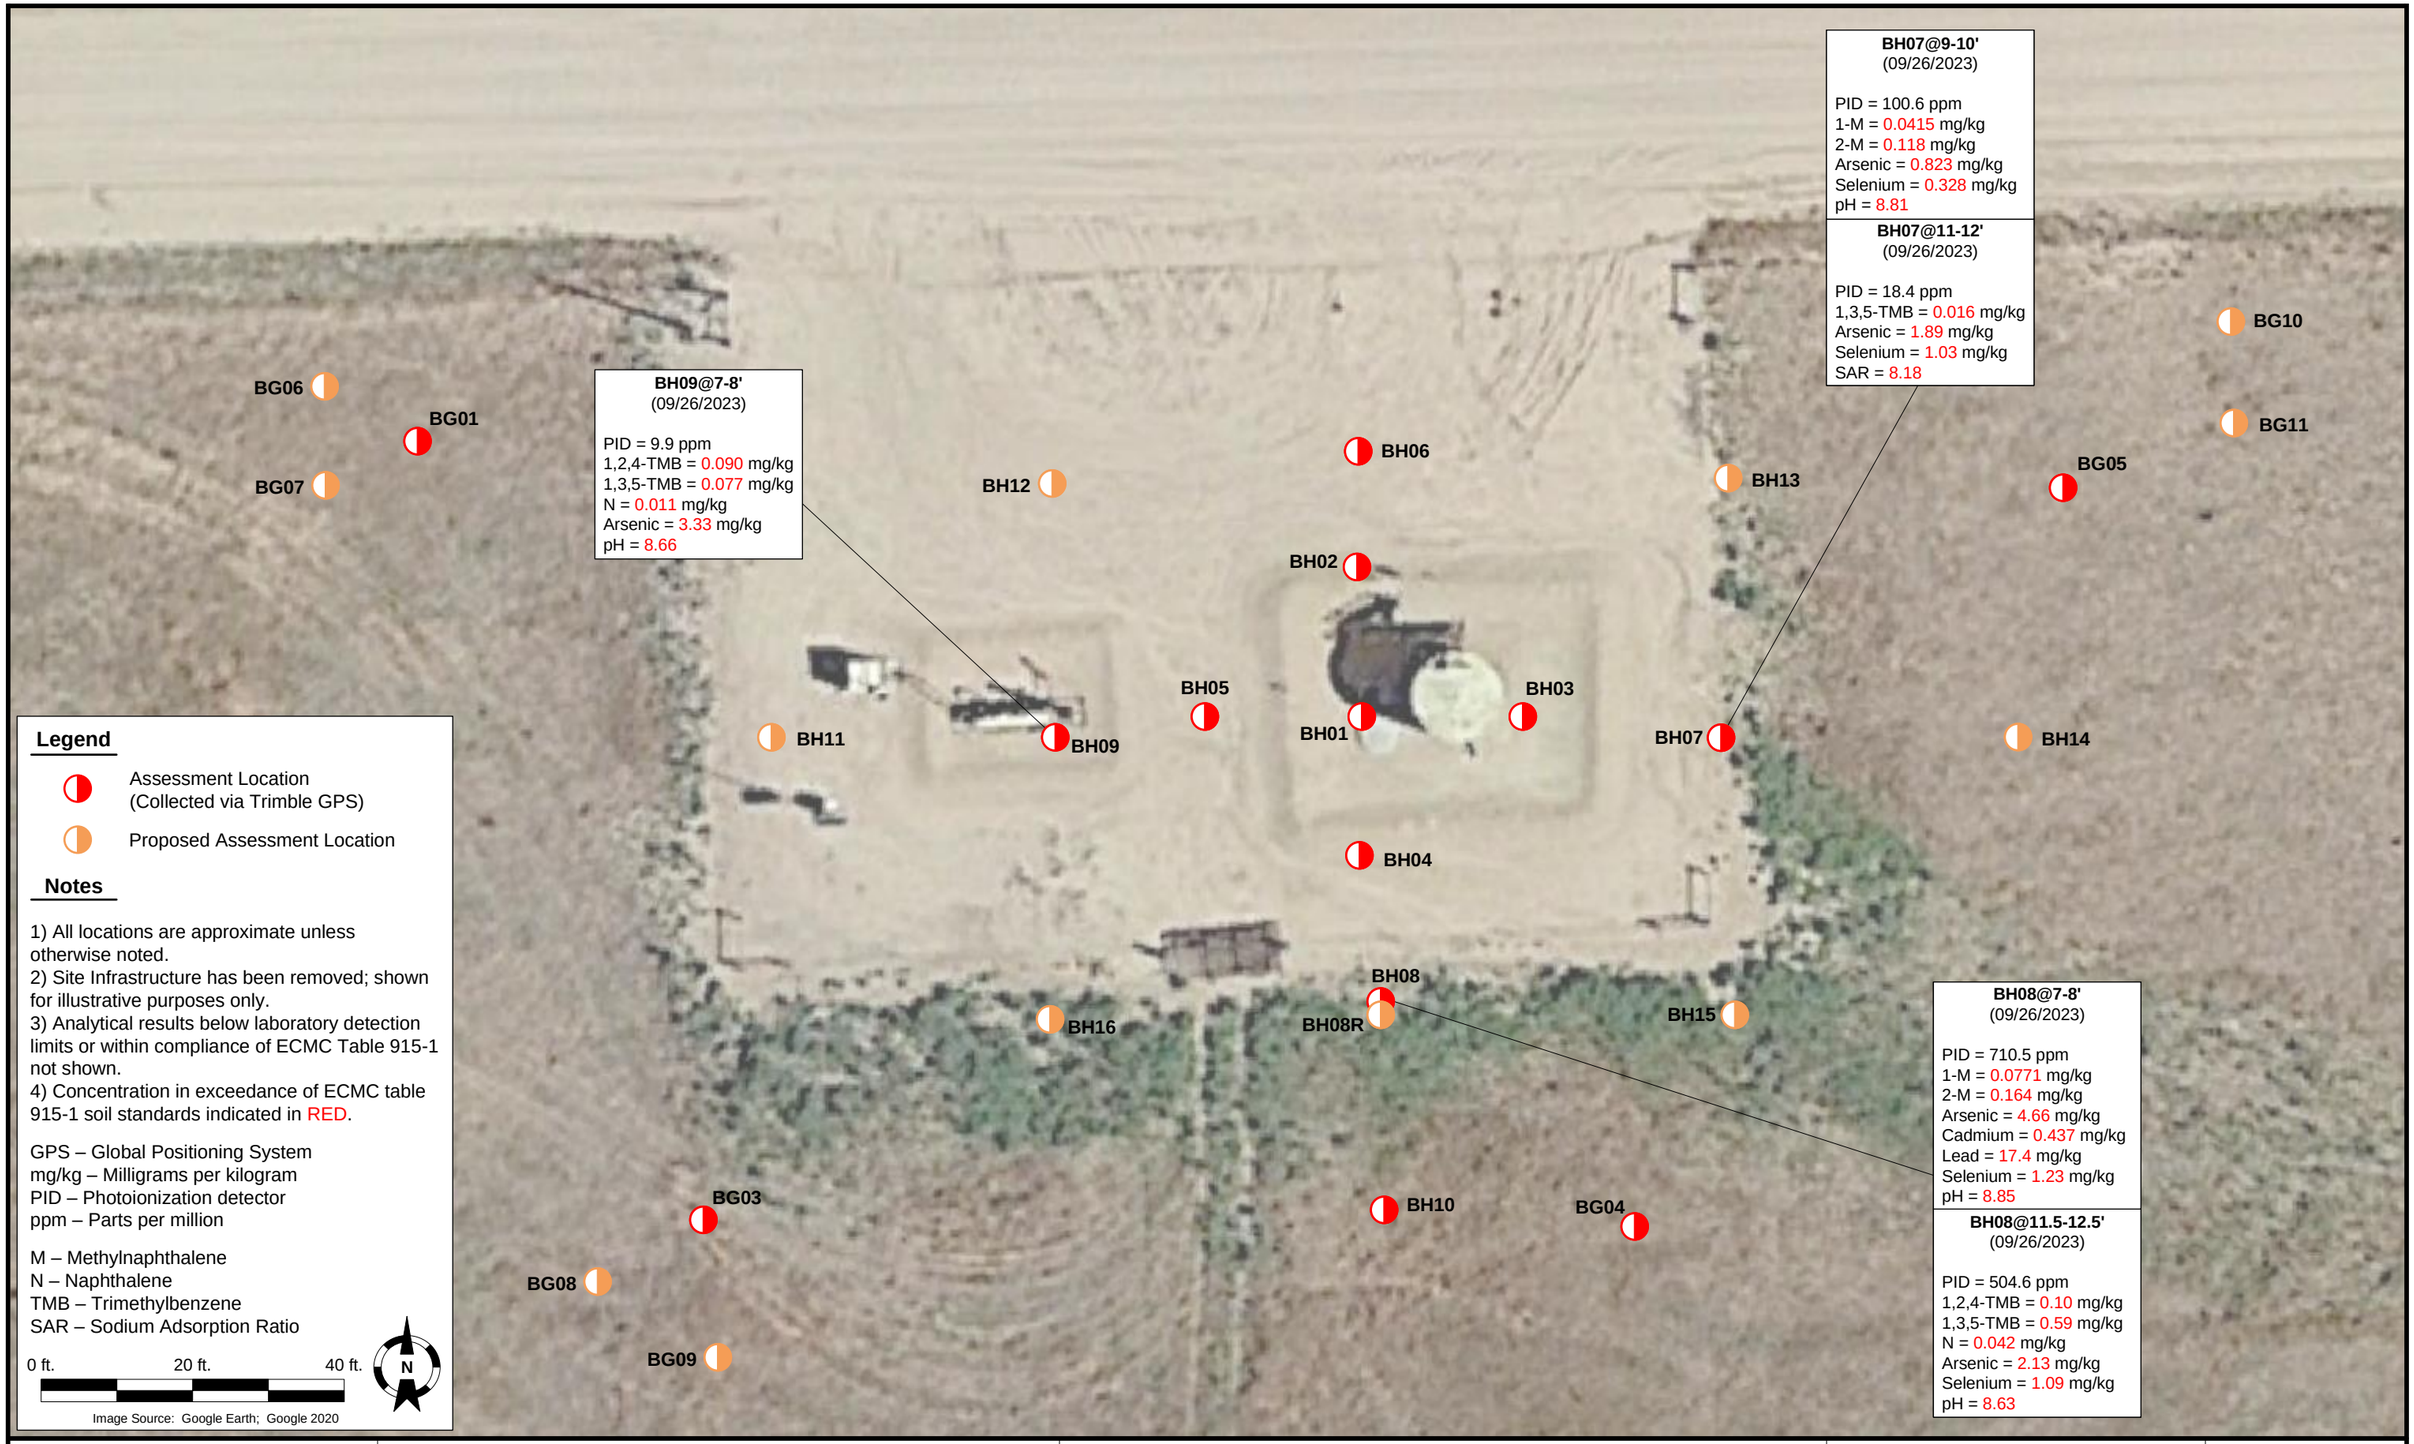

DATE: 07/22/2024 DESIGNED BY: JW DRAWN BY: ES	TASMAN **Tasman, Inc.** **6855 W 119th Avenue** **Broomfield, CO 80020**	**Noble Energy, Inc. – DJ Basin** **Kildow PMC 31-2 Facility** NWNE, Section 31, Township 4 North, Range 64 West Weld County, Colorado	Proposed SSI Soil Boring Assessment Map	FIGURE 5