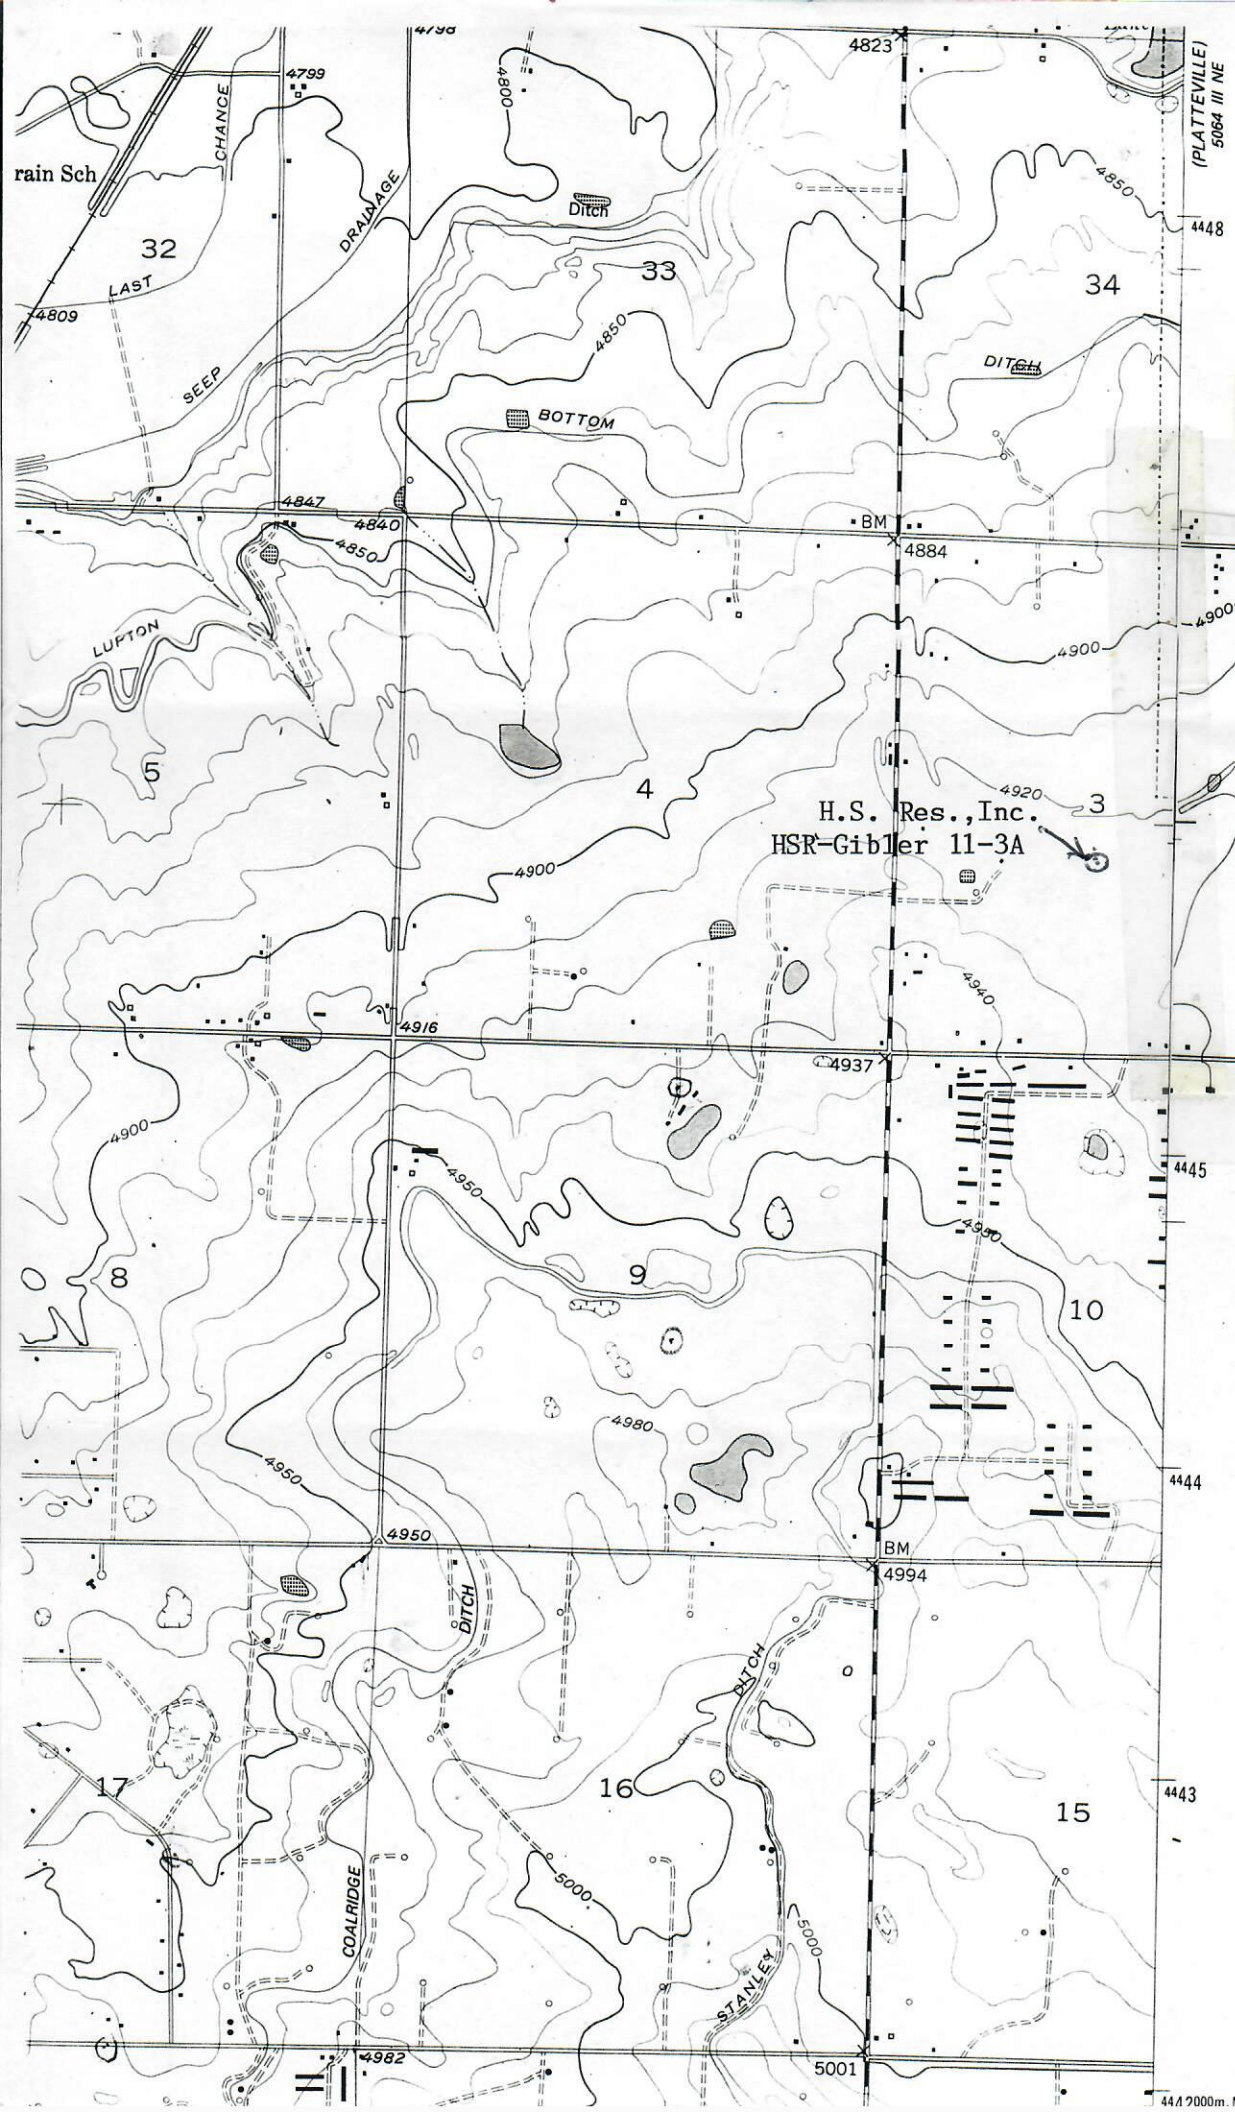

RECEIVED
MAY 11 00
COGCC

00815892