Exploration and Production

Current WBD

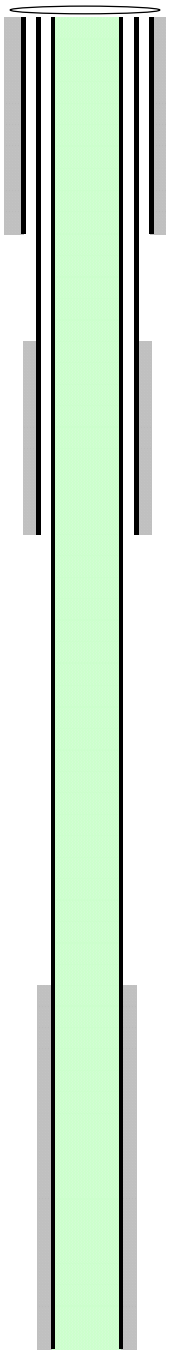

20" 80'

13-3/8" 1,335'

9-5/8" 2,985'

Well Name	**RG 921-24-299D**
Location	**Sec 24 T2S R99W**
State	**Colorado**
County	**Rio Blanco**
API	**05-103-12674**

Cond Casing	**80'**	**20"**	**78.6# X42 ERW**
Surf Casing	**1,335'**	**13-3/8"**	**54.5# J55 BTC**
Intermediate Casing	**2,985**	**9-5/8"**	**36.0# J55 BTC**
Prod Casing	**9,204'**	**5-1/2"**	**17# HCP-110 BTC**

Injection Intervals

Williams Fork	**5,435**
OCRK	**5,435**
TOC	**6,400**