


HALDE OIL, INC.

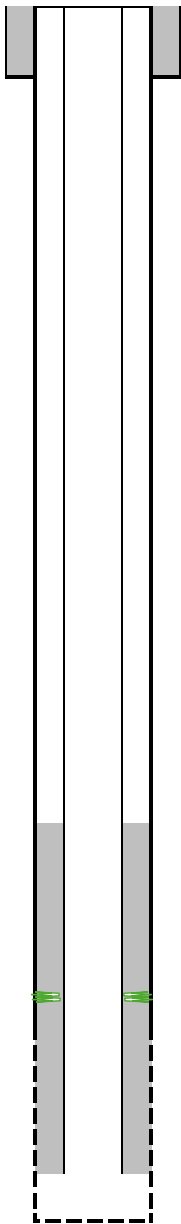

General Well Info		Updated:	8/1/24 jad
Well Name:	Jagee #1	Field:	Yellow Rose - 98620
Srf Location:	NENW S7 T18S R44W	County:	Kiowa
Lease # <sub>(BLM)</sub> :		State:	Colorado
API #:	05-061-06584	Spud Date:	11/1/1990
GL Elev:	4009'	TD Date:	11/14/1990
KB Elev:	4021'	Compl Date:	11/19/1990
Formation Tops			
Zone	Depth	Zone	Depth
Fort Hays		530' Whitehorse	1,700'
Codell		588' Blaine	1,945'
Dakota	1,033'	Cedar Hills	2,295'
Cheyenne	1,346'	Anhydrite	2,465'
Morrison	1,430'	Shawnee	3,619'
Taloga	1,610'	Lansing	3,895'
Day Creek	1,668'	Marmaton	4,278'

Srf Csg 12 1/4" hole, 8 5/8" 20# @ 316'  
Cmt 200 sx Class A, TOC @ surf

Prod Csg 7 7/8" hole, 5 1/2" 15.5# @ 4489'  
Cmt 100 sx Class A, TOC @ 3550' (CBL)

TOC @ 3550' (CBL)

MRTN 4379'-4384', 1/2", 12 holes

Open hole 4489' to 5225'

PBTD 4489'  
TD 5225'