


## Legend

- P&A'd Wellhead
- Soil Sample
- Soil Screening
- Soil Vapor Point (SVP)
- Background Soil Sample
- Groundwater Sample
- Approximate Location of Flowline (Removed)
- Excavation Extent

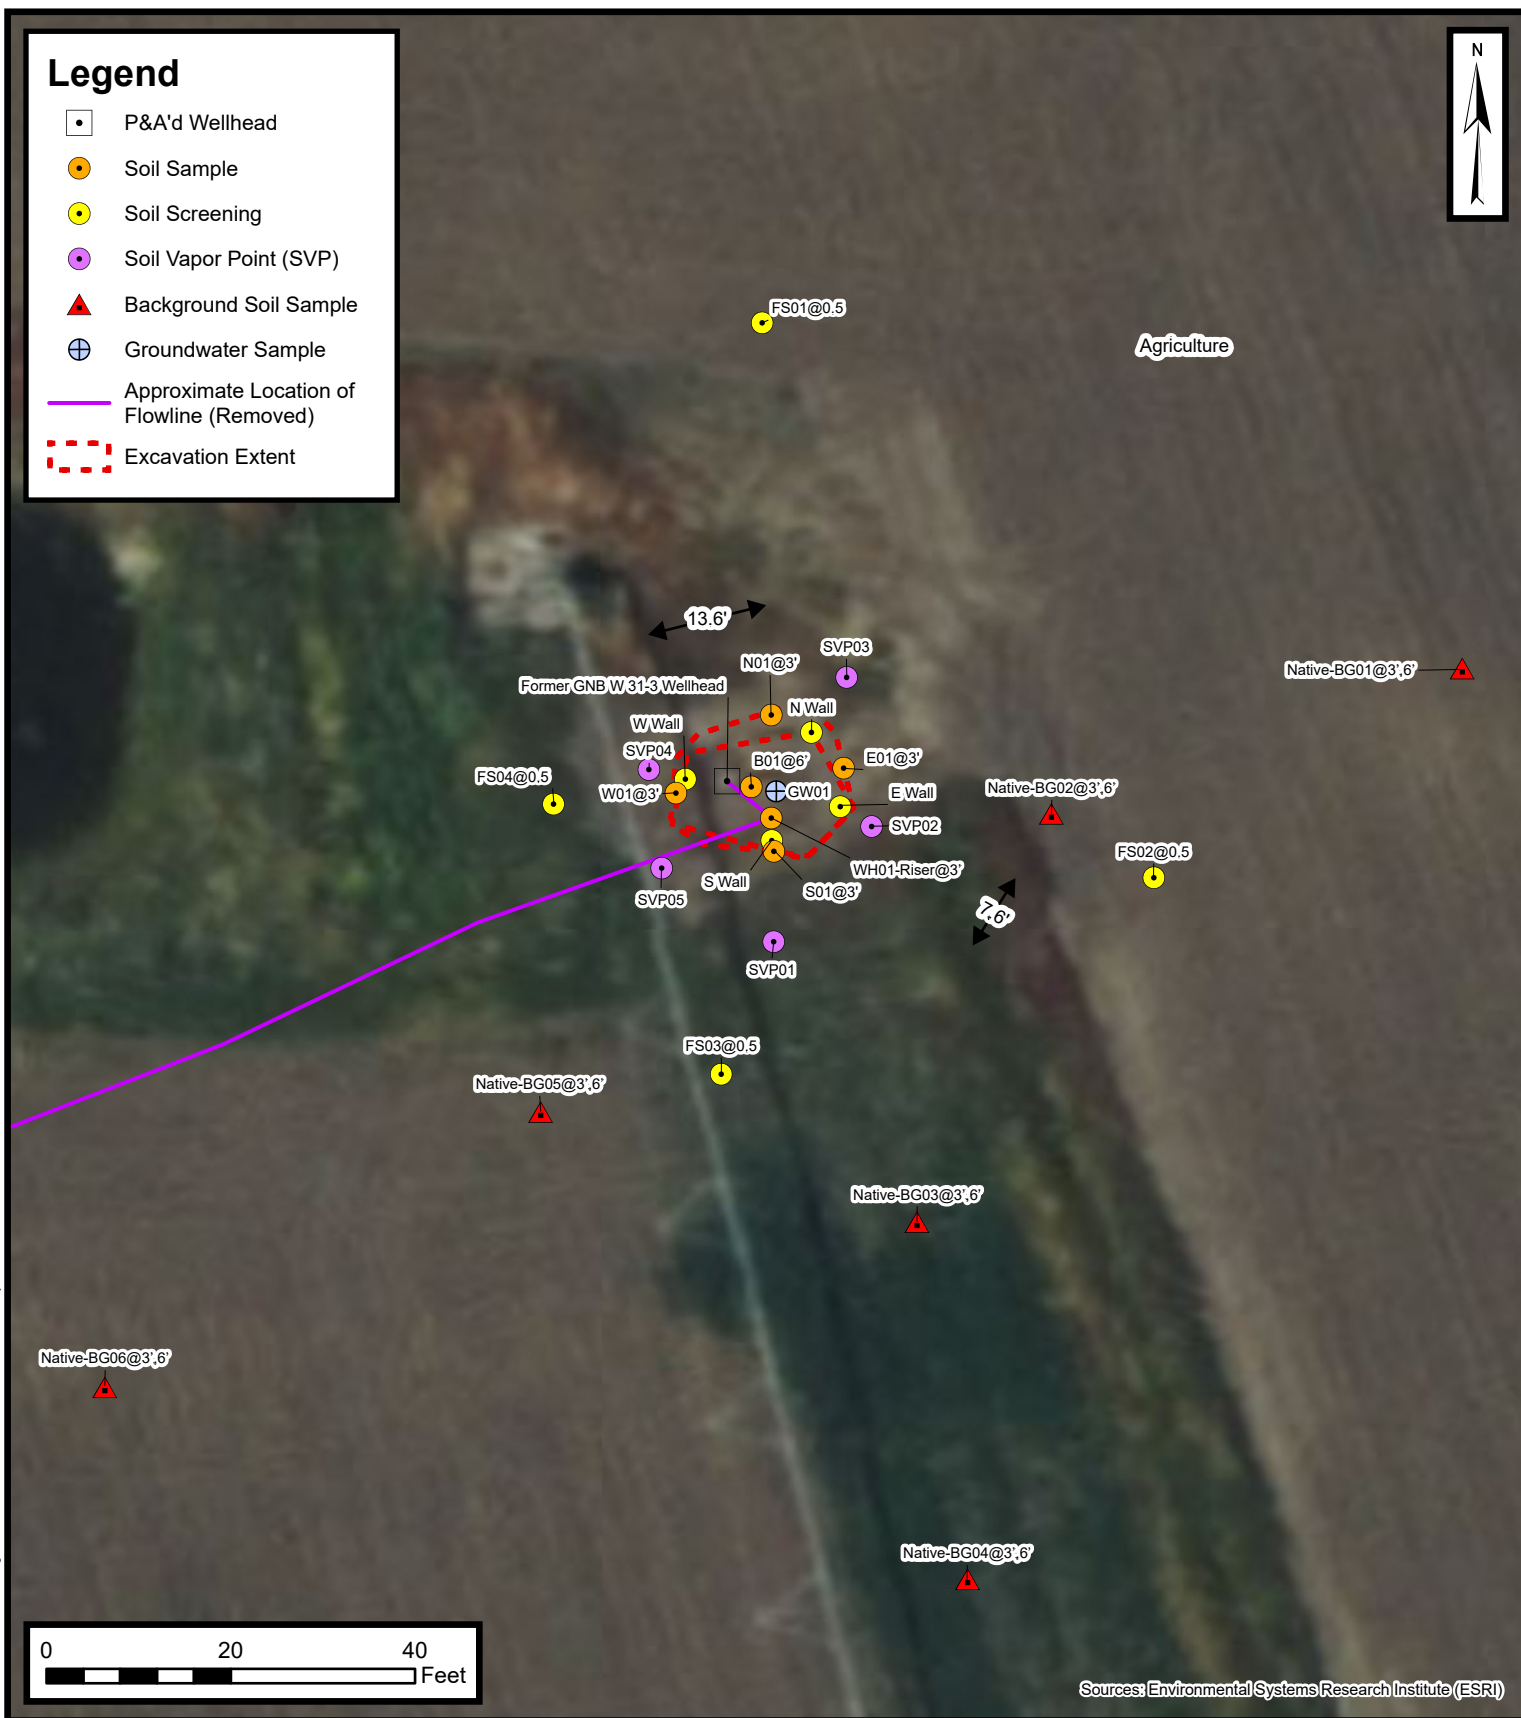

## Wellhead Excavation Site Map

GNB W 31-3 Wellhead  
Kerr-McGee Oil & Gas Onshore, LP  
NENW SEC 31-T2N-R66W  
Weld County, CO

Project Number: 09A1417646

FIGURE

1