

OIL AND GAS CONSERVATION COMMISSION
OF THE STATE OF COLORADORECEIVED
MAR 29 1965

Permit No.

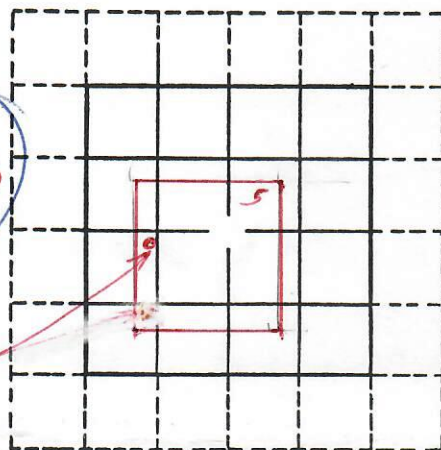
65.110

NOTICE OF INTENTION

OIL & GAS
CONSERVATION COMMISSION

INSTRUCTIONS:

A notice of intention to drill a well shall be filed in duplicate on all Federal and Patented lands, and in triplicate on all State lands. Do not begin operations until approved copy has been received. It is mandatory that the proposed location comply with all rules and regulations of the Commission. Locate well on section grid in proper location, and indicate extent of lease. Unless operations are commenced within 180 days after the date of approval hereof, this approval to drill will become null and void.

Name of Operator Ed. F. DelaneyPhone No. 675-8513Address P.O. Box No. 734City RangelyState Colorado 81648How is liability secured: Well Bond (Attached) ☒; Blanket Bond ☐; Waiver ☐
(Check one)Lease Name Tidewater - Pan-AmericanWell No. Brick well 2-4-5, Official Monicker Brick No. 3Field Name Rangely, ~~Semi-~~ Wildcat ☒County Rio BlancoLocation NW 1/4 lot 5 Section 4 Township 1N Range 102W Meridian 6th.
(quarter quarter)1125 feet from North ~~South~~ line and 375 feet from West ~~East~~ Section Line of lot 5
N or S E or WThe well is located on: Patented land ☒ State land ☐ Federal land ☐The well is located within a spaced area: Yes ☒ No ☐Distance from proposed location to nearest property or lease line 450 feet.Distance from proposed location to nearest drilling unit line 1000 plus feet.Objectives: 0 Depth 3500 Mancos Depth Estimate
Formation Estimate Formation EstimateProposed length of surface casing 100-125 feet. more if necessary

REMARKS:

Drill 12-1/4" hole, set necessary 8-5/8" casing for surface and cement same.

Will then drill ahead making 7-5/8" hole, will reduce hole size to 6-3/4" at 1500 feet/

If commercial production is found, will set either 4 1/2" or 5 1/2" casing, depending on depth oil horizon is encountered. Necessary rods and tubing will be added to place well on production, perforated casing will be installed through production zone.

I/We hereby swear (or affirm) that the statements herein made are a full and correct report.

APPROVED:

Date MAR 29 1965Company Ed. F. Delaney, opr. Date Feb. 1965Address P.O. Box No. 734Phone No. 675-8513By Ed. Delaney Title Operator.

Ed. Delaney Signature

Director

Permit No.

65.110

DVR	
WRS	
HHM	
JAM	<input checked="" type="checkbox"/>
FJP	
JJD	<u>Plotted 3/29/65</u>
FILE	