


WELL NAME:	STATE BIERSTADT 4-65 35-34 3BH					OPERATOR:	CRESTONE PEAK RESOURCES	
FIELD:	DJ HORIZONTAL NIOBRARA					FORMATION:	Niobrara	
SHL:	qtr-qtr	SENE	Section	35	Township	4S	Range	65W
BHL:	qtr-qtr	NWSW	Section	34	Township	4S	Range	65W
COUNTY:	ARAPAHOE		STATE:	CO		API:	05-005-07556-00	

not to scale	
GROUND LEVEL:	5870
KELLY BUSHING:	5895
SPUD DATE:	2/28/2024
TD DATE:	4/10/2024

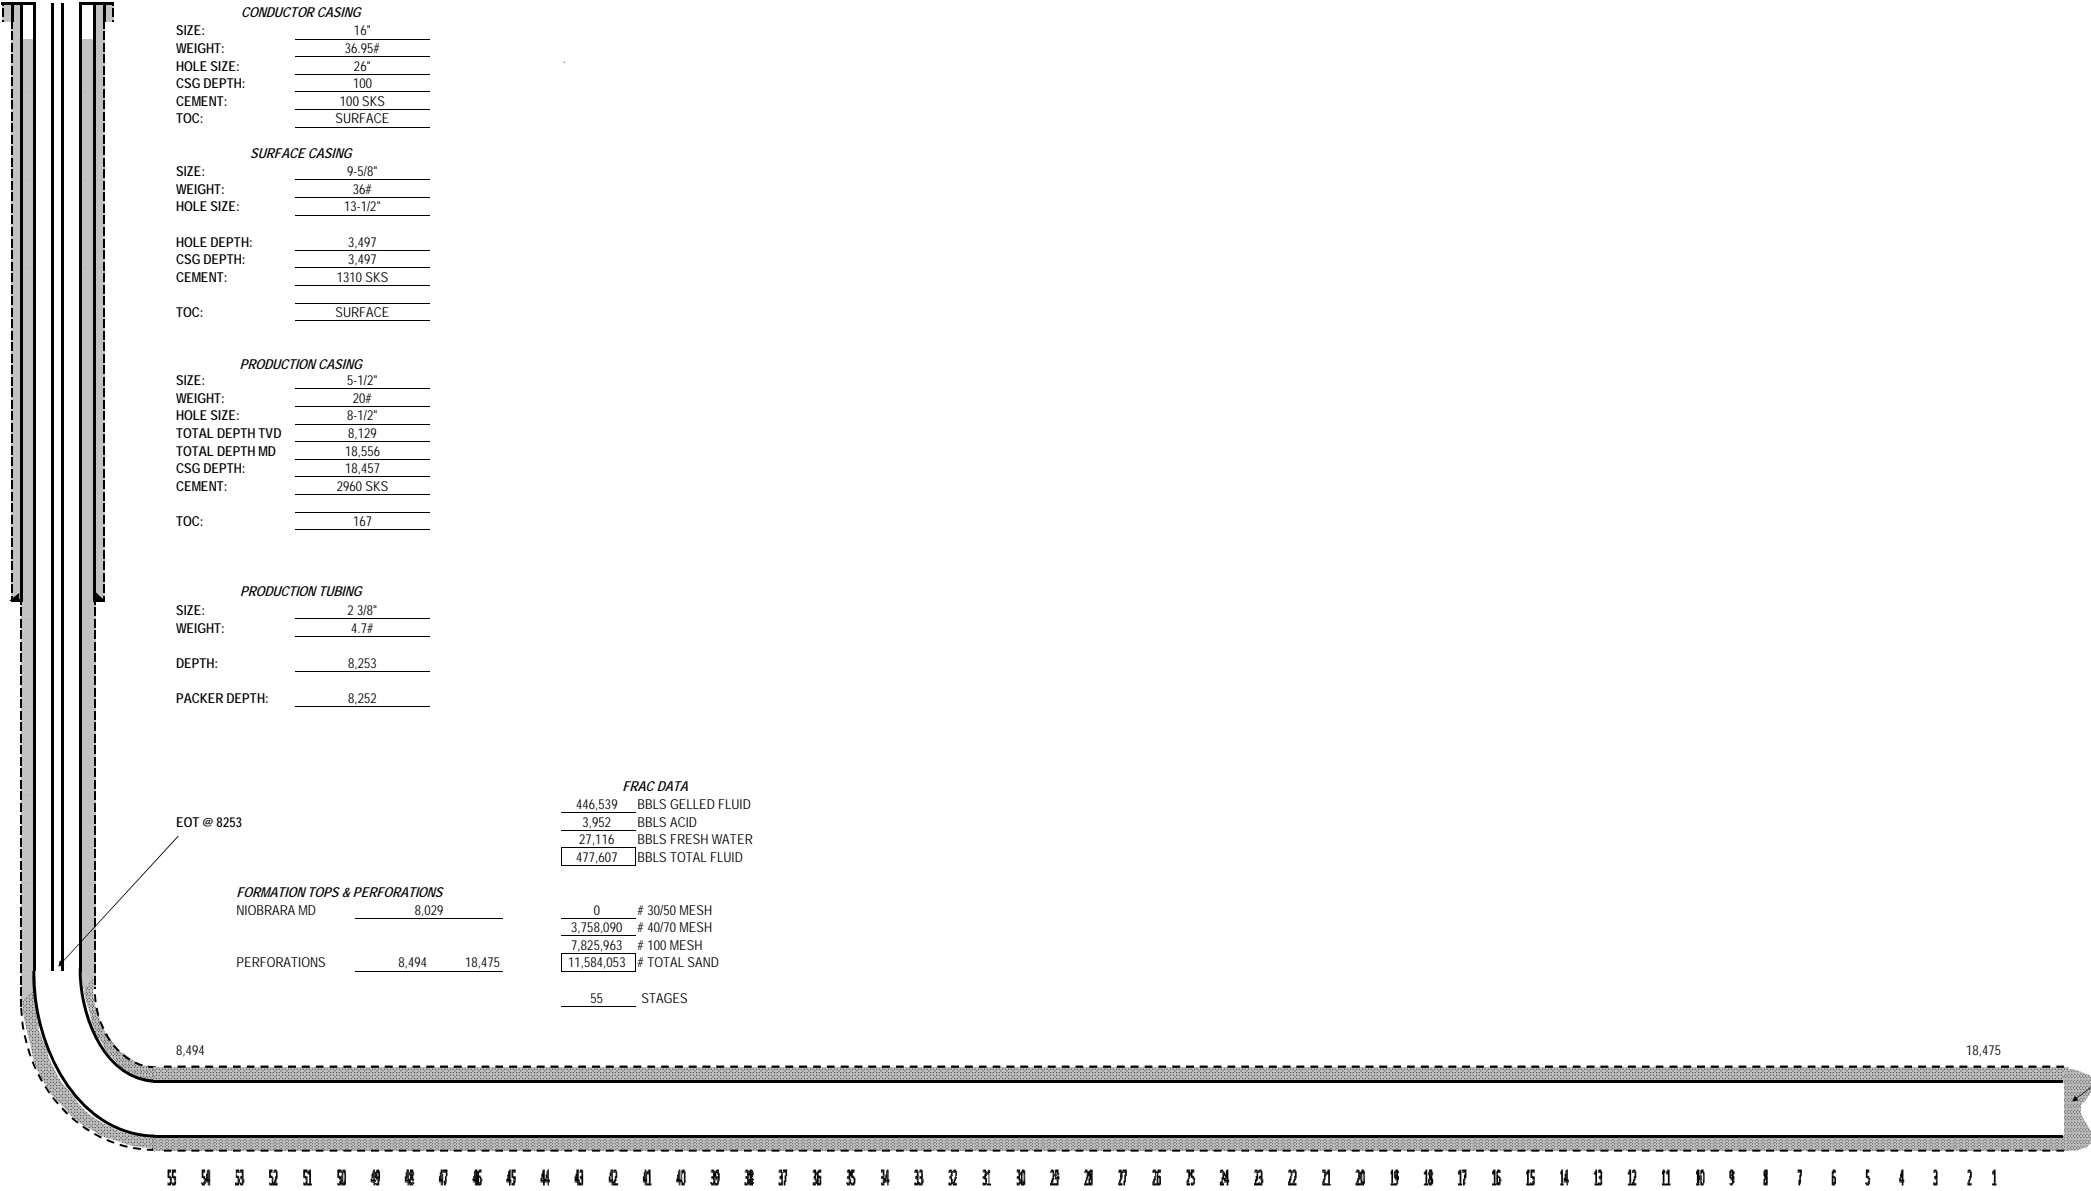

EOT @ 8253

FORMATION TOPS & PERFORATIONS		
NIOBRARA MD	8,029	
PERFORATIONS	8,494	18,475

FRAC DATA		
446,539	BBLS GELLED FLUID	
3,952	BBLS ACID	
27,116	BBLS FRESH WATER	
477,607	BBLS TOTAL FLUID	
0	# 30/50 MESH	
3,758,090	# 40/70 MESH	
7,825,963	# 100 MESH	
11,584,053	# TOTAL SAND	
55	STAGES	

Production Csg @ 18457'

MD TD 18,556