



00053242

OIL AND GAS CONSERVATION COMMISSION OF THE STATE OF COLORADO

RECEIVED JUN 20 1963

OIL & GAS CONSERVATION COMMISSION

NOTICE OF INTENTION TO DRILL


INSTRUCTIONS:

A notice of intention to drill a well shall be filed in duplicate on all Federal and Patented lands, and in triplicate on all State lands. Do not begin operations until approved copy has been received. It is mandatory that the proposed location comply with all rules and regulations of the Commission. Locate well on section grid in proper location, and indicate extent of lease. Unless operations are commenced within 180 days after the date of approval hereof, this approval to drill will become null and void.

Name of Operator: Woosley et al Phone No. Address: Box 416 City: Rangely State: Colorado

How is liability secured: Well Bond (Attached) []; Blanket Bond []; Waiver [] (Check one)

Lease Name: Colorado - 028499 Well No.: 3-W Field Name: Rangely Wildcat [] County: Rio Blanco

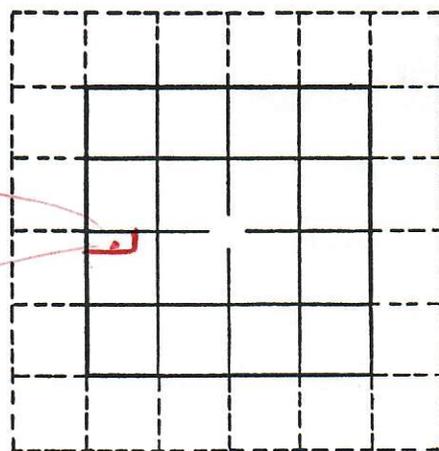

Location: Lot 10 (quarter quarter) Section 4 Township 1-N Range 102-W Meridian 6th PM 50 feet from S Section line and 350 feet from E Section Line of lot 10

The well is located on: Patented land [] State land [] Federal land []

The well is located within a spaced area: Yes [] No []

Distance from proposed location to nearest property or lease line: feet. Distance from proposed location to nearest drilling unit line: feet.

Objectives: Formation Depth Estimate; Formation Depth Estimate

Proposed length of surface casing: feet.

REMARKS:

Drill well to test Mancos shale formation, being a shallow well with estimated depth of 2,500'.

Table with columns for Agen, Bond, Spot, 600 ft, 1200 ft, Wells, Oil, Gas, Status. Includes handwritten notes like 'Pott 24/20/63' and 'Shale'.

I/We hereby swear (or affirm) that the statements herein made are a full and correct report.

APPROVED: Date: JUN 20 1963 Director: [Signature]

Company: William G. Waldeck Date: 6-18-63 Address: P.O. Box 359 Montrose Colorado Phone No. By: Frances Woosley Signature Title: Operator