

Well Latitude / Longitude:

40.50619/-104.44817

Flowline Point A (Lat / Long):

#N/A

Flowline Point B (Lat / Long):

40.506151/-104.448195

Flowline Length (ft):

1633

Flowline Abandonment Type:


Full Removal

Comments:

**X = Proposed Soil Sample Location**

**☐ = Area of Conflict, Proposed  
Flowline Abandon-in-Place Area**

**● = Field Screening Location**

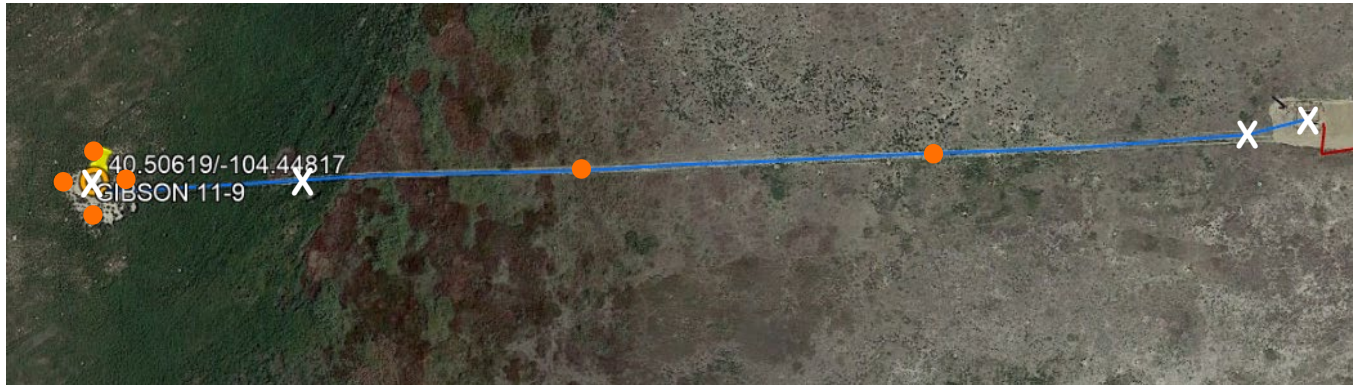

Map Created Date:

08/21/2023

Well Name:

GIBSON 11-9

Map Created By:

Sharon Strum

Well API:

05-123-23102

**the**  
**human energy**  
**company**<sup>™</sup>