


# KPK Dechant State 3 Flowline Spill

September 2023 Google Earth Imagery

## Legend

- Approximate Dechant State 3 Flowline Spill Footprint
- ▲ Dechant State Flowline Spill

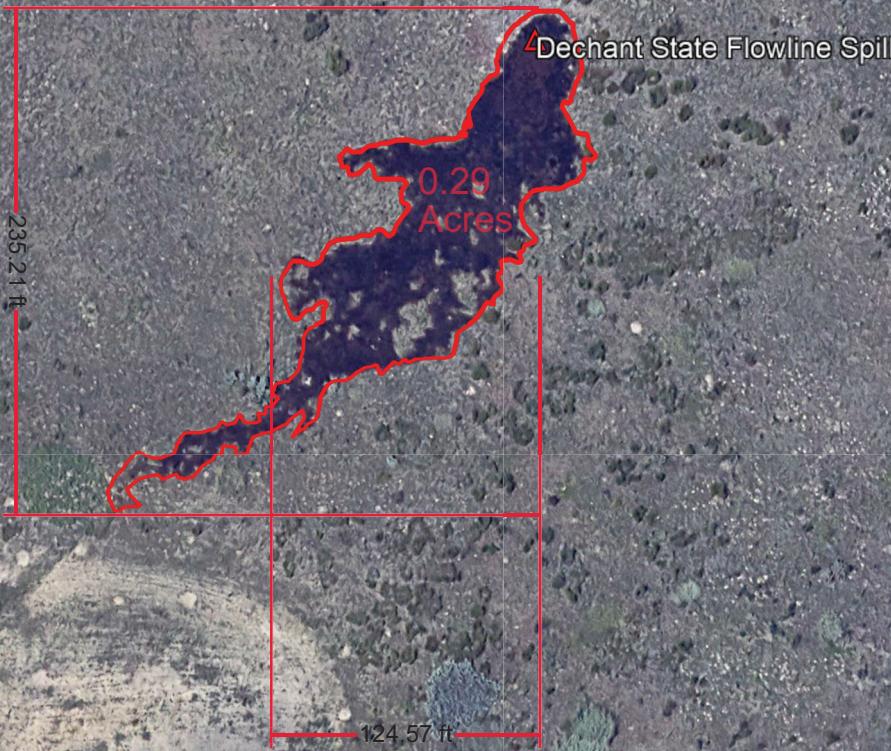

N

Google Earth

300 ft