

## RECEIVED

0459 23 1980



00052400

COLO. OIL & GAS CONS. COM.

BURTON-HAWKS INC. (LINKE WELL 23-1)


SHEET NO 1 OF 1

CALCULATED BY MLO DATE 10/9/80

CHECKED BY PJO DATE 10/10/80


SCALE 1" = 1000'

NOTE: Bench Mark Elevation (8308.00'), at intersection of County Road No.55 and 4x4 road, in the West  $\frac{1}{2}$  of Section 23, T1N, R77W, from USGS Quadrangle 1957 Granby, Colorado.

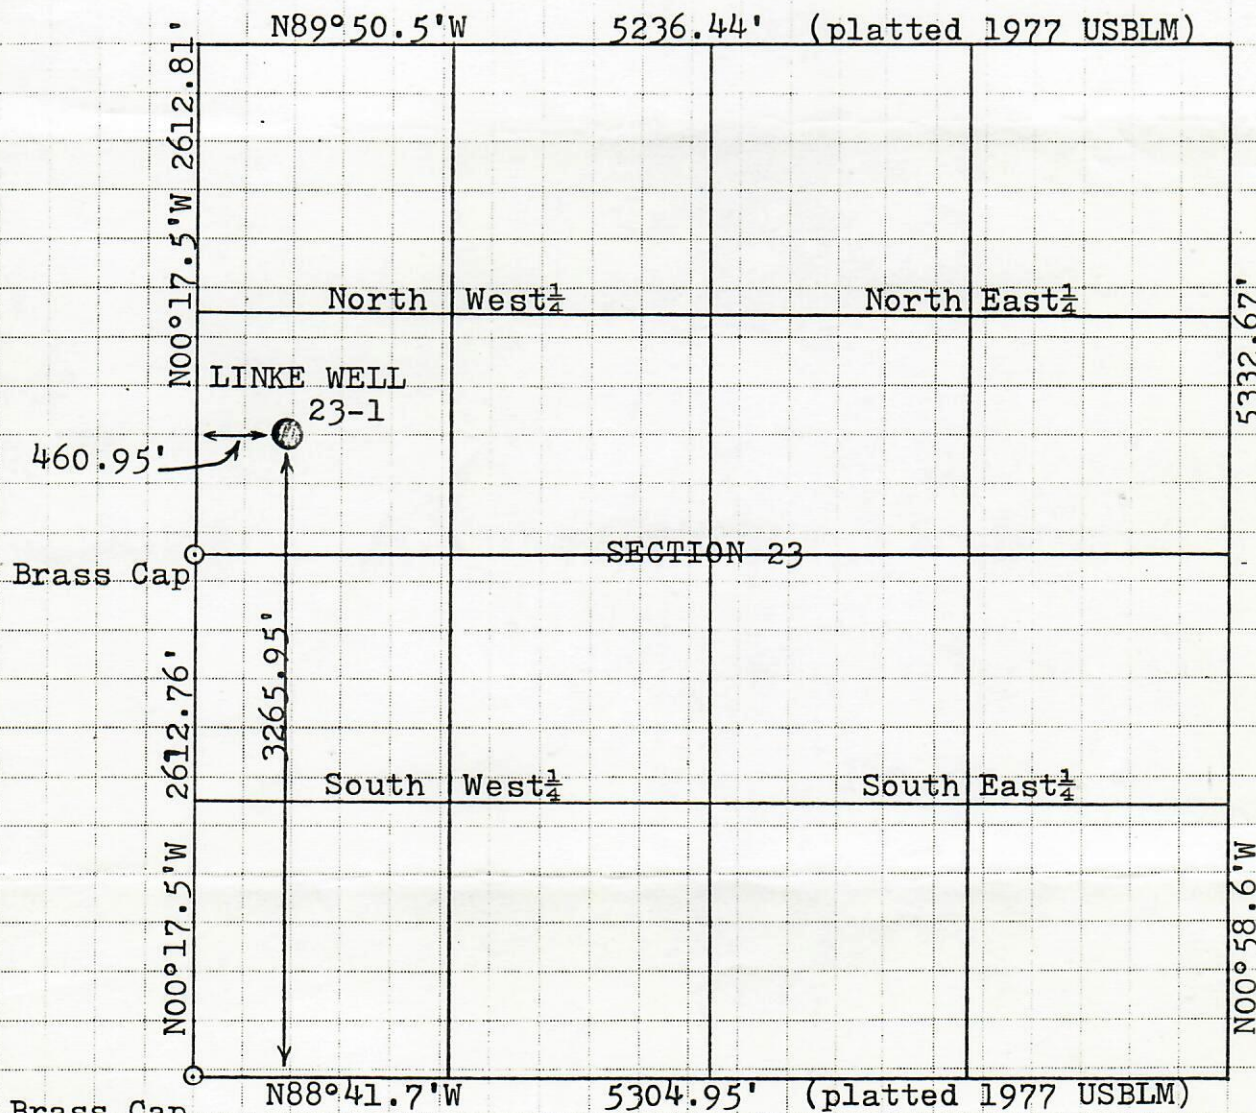

Well Elevation = 8338.60'

I, Paul J. Ohri, hereby certify that the survey shown and described on this plat was done by me and under my supervision, and that this plat shows the actual results of that survey to the best of my knowledge.

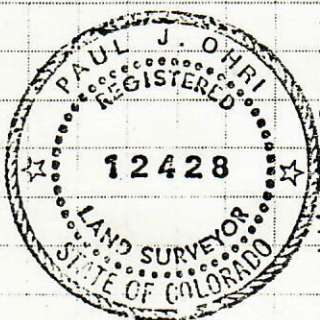

Paul J. Ohri Colo. RLS No.12428