


Legend

- Soil Sample
- Soil Screening
- ▲ Background Soil Sample
- M Former Meter House
- × — Former Fence
- Former Metal Berm
- Former Infrastructure
- Excavation Extent

Notes

AST: Above Ground Storage Tank
 PWV: Produced Water Vessel
 ECD: Emission Control Device

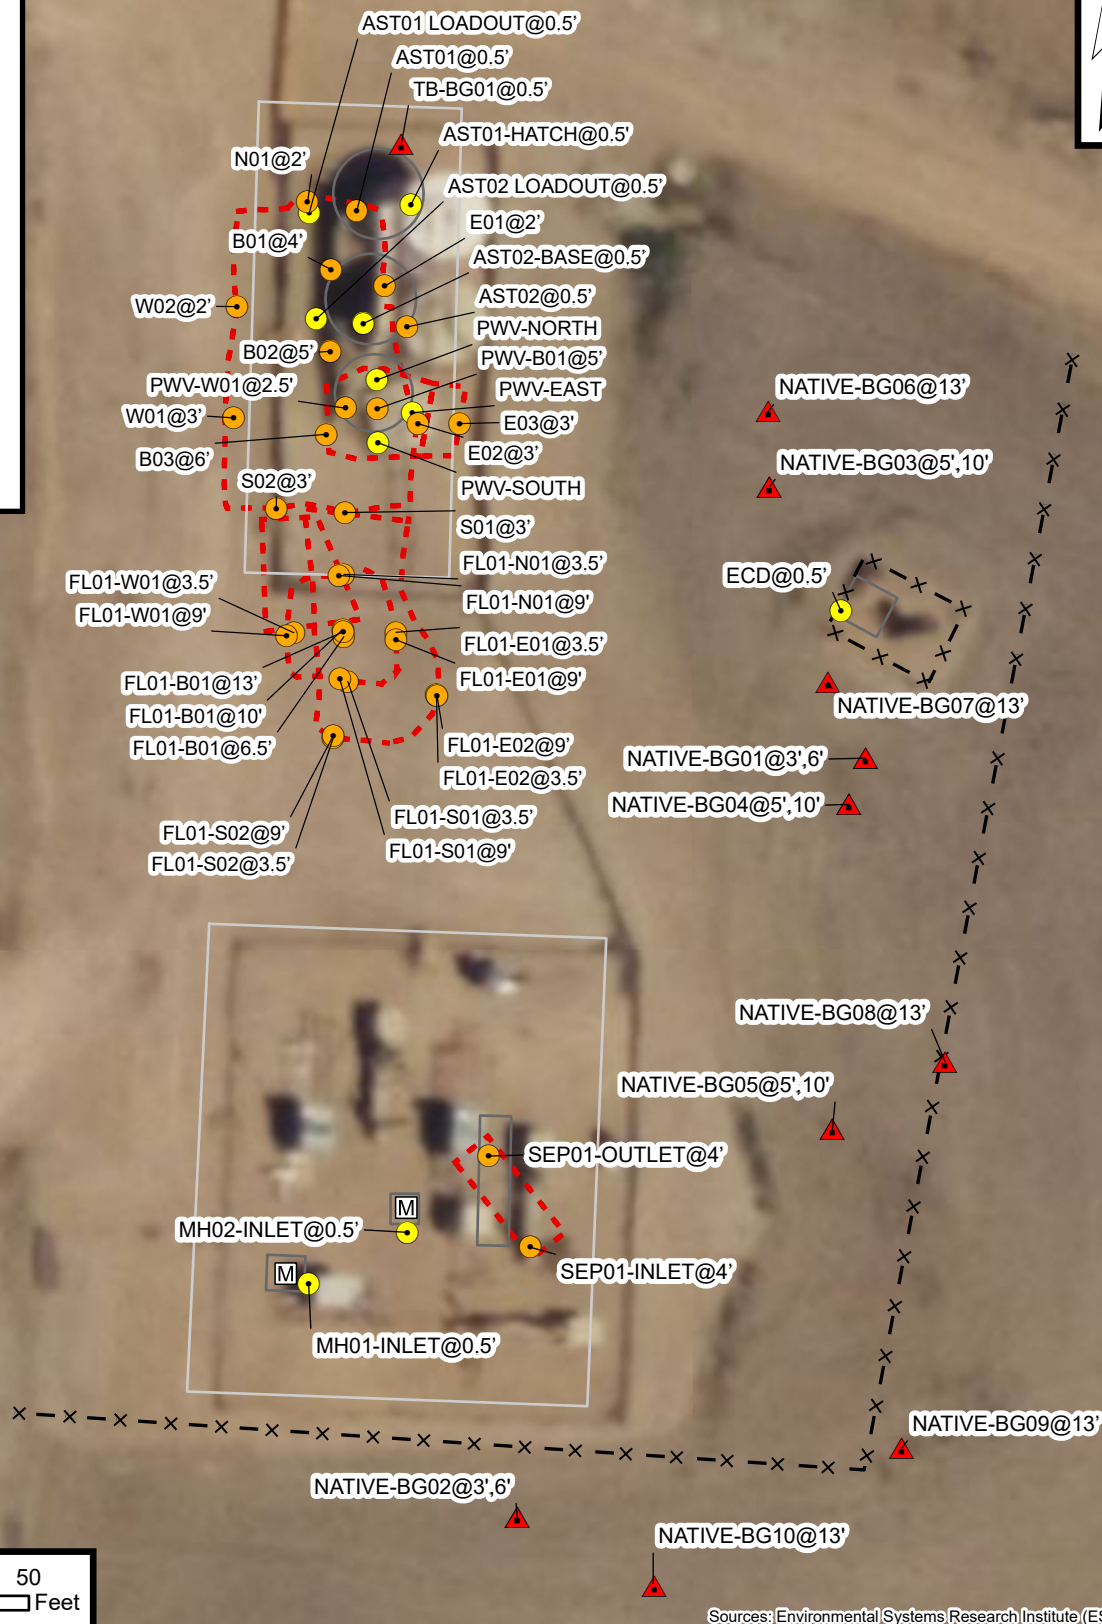

0 25 50 Feet

Sources: Environmental Systems Research Institute (ESRI)

Excavation Site Map (10/23/2023 - 2/2/2024)

PSC 15-10FSV, 24A&4 O SA Facility
 Kerr-McGee Oil and Gas Onshore, LP
 NWSE SEC 10-T3N-R67W
 Weld County, Colorado

Project Number: 09A1417329

FIGURE
 1A